



 Gachsaran Polymer Industries Company	Gachsaran Polymer Industries Company HDPE Plant		
	General Arrangement Drawing (2D) (*Tie-In Points , Skid Dimensions & Orientation, Including Instrument, Junction Box and Local Panel Location Layout & Instrument Cable routing.) for Refrigerator Package	 	
PO No.: GPIC-PT-MA-PO-000-3029	Document Number: VD-GPIC-MA-3029-3029-0062	Rev. 02	Page 1 of 11

General Arrangement Drawing (2D) (*Tie-In Points , Skid Dimensions & Orientation, Including Instrument, Junction Box and Local Panel Location Layout & Instrument Cable routing.) for Refrigerator Package

Code1	<input type="checkbox"/> No Comment/ Approved (Applicable Only for "FOR REVIEW" and "For Approval" Documents) No comment and the document are released for Manufacturing.
Code2	<input type="checkbox"/> No Comment/ Approved with Note(s) Vendor/Sub-Contractor shall correct, revise and resubmit the document. The document is released for Manufacturing if changes incorporated.
Code3	<input checked="" type="checkbox"/> Commented Vendor/Sub-Contractor shall correct, revise and resubmit the document by the date specified. The document shall be revised under the Status of "R: Revised Issue". All corrected documents shall be resubmitted before starting the Manufacturing Process.
Code 4	<input type="checkbox"/> Not Accepted (Rejected) Vendor/Sub-Contractor shall re-work / re-design / re-specify the contents of the document according to the comments / reasons for rejection. All corrected documents shall be resubmitted before starting the manufacturing. Vendor/Sub-Contractor shall not proceed with subsequent works of Material Supply or Manufacturing until receiving Code1/Code2 or No Code from PURCHASER. Vendor/Sub-Contractor shall resubmit the document with the same revision within 6 working days after receiving comments.
No code	<input type="checkbox"/> No Code (Applicable Only for "For Information" Documents and "As Built DWGs") Document has been submitted for PURCHASER's Information (FI). Consistency, completeness and correctness of document content is in Vendor/Sub-Contractor's responsibility.
Above checking results by EIED shall in no way relieve Vendor of any liability, obligation and responsibility out of the purchase order and the mutual agreement in writing.	
 Energy Industries Engineering & Design co.	Date: Oct. 20, 2025 Dept.: MA Signature: F.Hamooni

02	9-Oct-25	IFR	N.B	A.M	F.T
01	16-Sep-25	IFR	A.M	A.M	F.T
00	28-Jun-25	IFR	A.M	A.M	F.T
Rev.	DATE	PURPOSE OF ISSUE	PREPARED	CHECKED	APPROVED

EL-3

The incoming power and control cables enter from the top of the package. According to the Material Requisition, the vendor shall consider, supply, and install the required cable trays, and clearly show the routing within the package boundary for all internal cabling. The routing of power cables up to the motor terminal boxes (LV/MV) shall be separated, and there shall be no interference or crossing between low-voltage and medium-voltage cable routes. In addition, LCP cable routes shall be completely independent from other cabling systems. All welding, supporting structures, and installation works inside the package — such as cable trays and earthing connections — shall be carried out by the manufacturer. No action will be required from the client at site for this purpose.

Main Cable Route


Considering input route from this location by manufacturer for each MV Motor & LV Motor & LCP & other such as heat tracing JB





IN-01. In addition to GA, this document is cable route and for cable route, symbol for instrument cable tray/ladder/conduit/JB shall be specified clearly and related cable route shall be shown in the drawing.
 IN-02 Tag number of all JB and LCP shall be added to this drawing. For tag number of JB, please refer to our comments on IO list.
 IN-03. Width/depth/size of trays/ladders/conduits shall be added and shown in this drawing.


PI COMMENT:
 The customer (EIED) shall provide with the STP and navies file of model. The all of TI in/out shall be specified in all views. The S-44,43,42,T-4A1 tags shall be specified in all of views. The distance between skids in north and east direction shall be specified in plan view, for example the distance between vessel skid and compressor skid in the east or west direction shall be specified in plan view.

NOTES:

- FOR OPERATING AND DRY WEIGHTS, REFER TO VD-GPIC-MA-3029-3029-0071
- FOR CENTER OF GRAVITY, REFER TO VD-GPIC-MA-3029-3029-0071
- FOR DYNAMIC AND STATIC LOADS, REFER TO VD-GPIC-MA-3029-3029-0071
- FOR FOUNDATION DETAIL DRAWING, REFER TO VD-GPIC-MA-3029-3029-0071
- FOR LIFTING DETAILS, REFER TO VD-GPIC-MA-3029-3029-0062
- FOR SKID INSTALLATION, REFER TO INSTRUCTION AND OPERATIONAL MANUAL VD-GPIC-MA-3029-3029-0008
- DIMENSIONS ARE IN INCHES AND MM IN PARENTHESIS.
- ANCHOR HOLES TOLERANCES ± 0.13 in (± 3.2 mm).
- BEAM LOCATION TOLERANCES: ± 0.13 in (± 3.2 mm).
- NON-SKID GRATING UNDER MAINTENANCE AREA IS NOT INCLUDED.
- SKID FLATNESS SHALL BE 0.0625" (1.6 mm).
- SURFACE PREPARATION SHALL BE PER PROJECT PAINTING SPECIFICATION.
- ANCHOR BOLT HOLES SHALL BE WITHIN THE SAME XY AND XZ PLANES WITHIN ± 0.13 in (± 3.2 mm).
- COMPRESSOR SKIDS SHALL BE GROUTED. GROUT SPECIFICATION AND SELECTION BY OTHER AND SHALL BE SUITABLE TO PAINTING APPLICATION.
- FOR PIPE NOZZLE LOADS REFER TO DOCUMENT NUMBER VD-GPIC-MA-3029-3029-0062-G (ULT003-20011G)


Code1	<input type="checkbox"/> No Comment/ Approved (Applicable Only for "FOR REVIEW" and "For Approval" Documents) No comment and the document are released for Manufacturing				
Code2	<input type="checkbox"/> No Comment / Approved with Note(s) Vendor/Sub-Contractor shall correct, revise and resubmit the document. The document is released for Manufacturing if changes incorporated.				
Code3	<input type="checkbox"/> Commented Vendor/Sub-Contractor shall correct, revise and resubmit the document by the date specified. The document shall be reissued under the Status of "Revised Issue". All corrected documents shall be resubmitted before starting the Manufacturing Process				
Code4	<input type="checkbox"/> Not Accepted (Rejected) Vendor/Sub-Contractor shall re-work/re-design/re-specify the contents of the document according to the comments/reasons for rejection. All corrected documents shall be resubmitted before starting the manufacturing. Vendor/Sub-Contractor shall not proceed with subsequent work of Material Supply or Manufacturing until receiving Code1/Code2 or No Code from PURCHASER. Vendor/Sub-Contractor shall resubmit the document with the same revision within 6 working days after receiving comments				
No Code	<input type="checkbox"/> No Code (Only for "For Information" Documents and "As Built DWGs") Document has been submitted for PURCHASER'S information (I). Consistency, completeness and correctness of document content is in Vendor/Sub-Contractor's responsibility. The above checking result by EIED shall in no way relieve Vendor of any liability, obligation and responsibility out of the purchase order and the mutual agreement in writing				
DATE : DEPT : Signature : 					
CV	PI	EL	IN	ME	MA
ST	BU	PR	SA	HV	TL

02	09.10.2025	IFR	FA	IM	OG
01	16.09.2025	IFR	FA	IM	OG
00	28.06.2025	IFR	FA	IM	OG
REV.	DATE (DD.MM.YY)	Purpose of Issue	Prepared	Checked	Approved
 		Gacharan Polymer Industries Company HDPE Plant		 	
PO No.: GPIC-PT-MA-PO-000-3029 SCALE: 3/8":1'					
DRAWING TITLE: General Arrangement Drawing (2D) (*Tie-In Points, Skid Dimensions & Orientation, Including Instrument, Junction Box and Local Panel Location Layout & Instrument Cable routing.) for Refrinator Package					
DRAWING NO. VD-GPIC-MA-3029-3029-0062		REV.	SHEET NO.	SIZE	
		02	3 OF 11	A1	

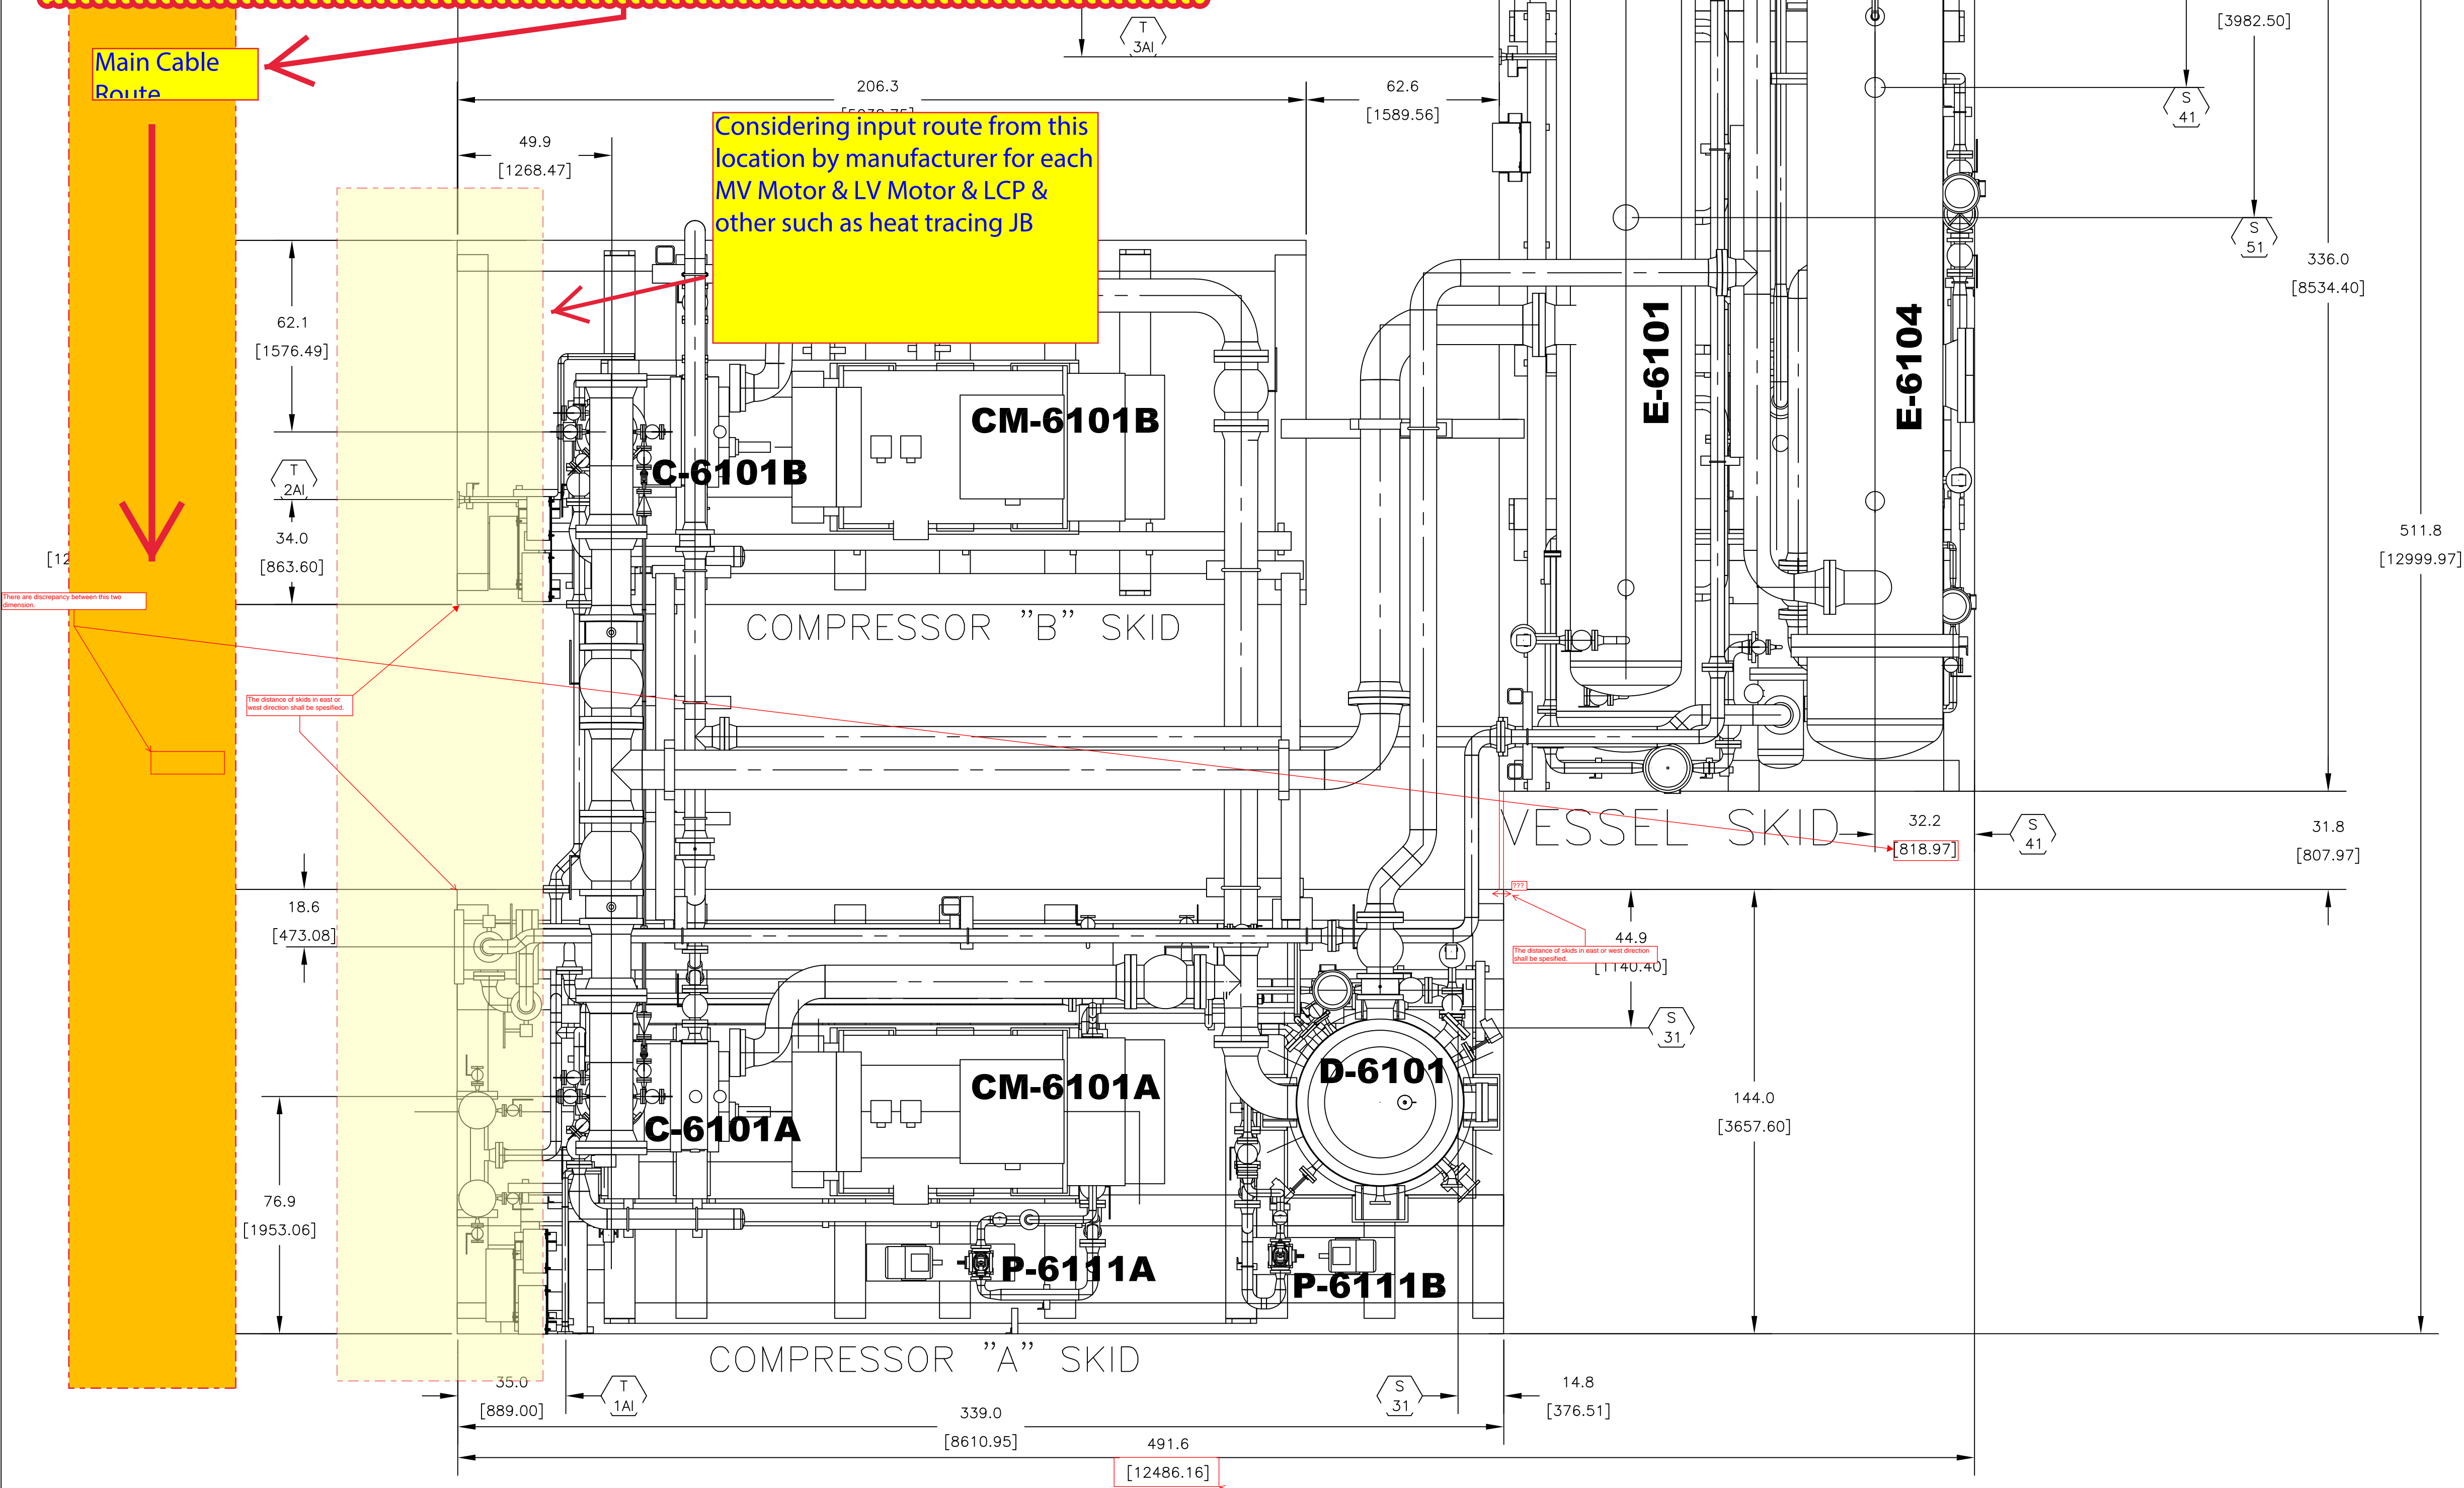

This dimension has discrepancy with total length of skids. See per given drawing total length of skids is 11248.60

The all of tags (TI) must be specified in this view

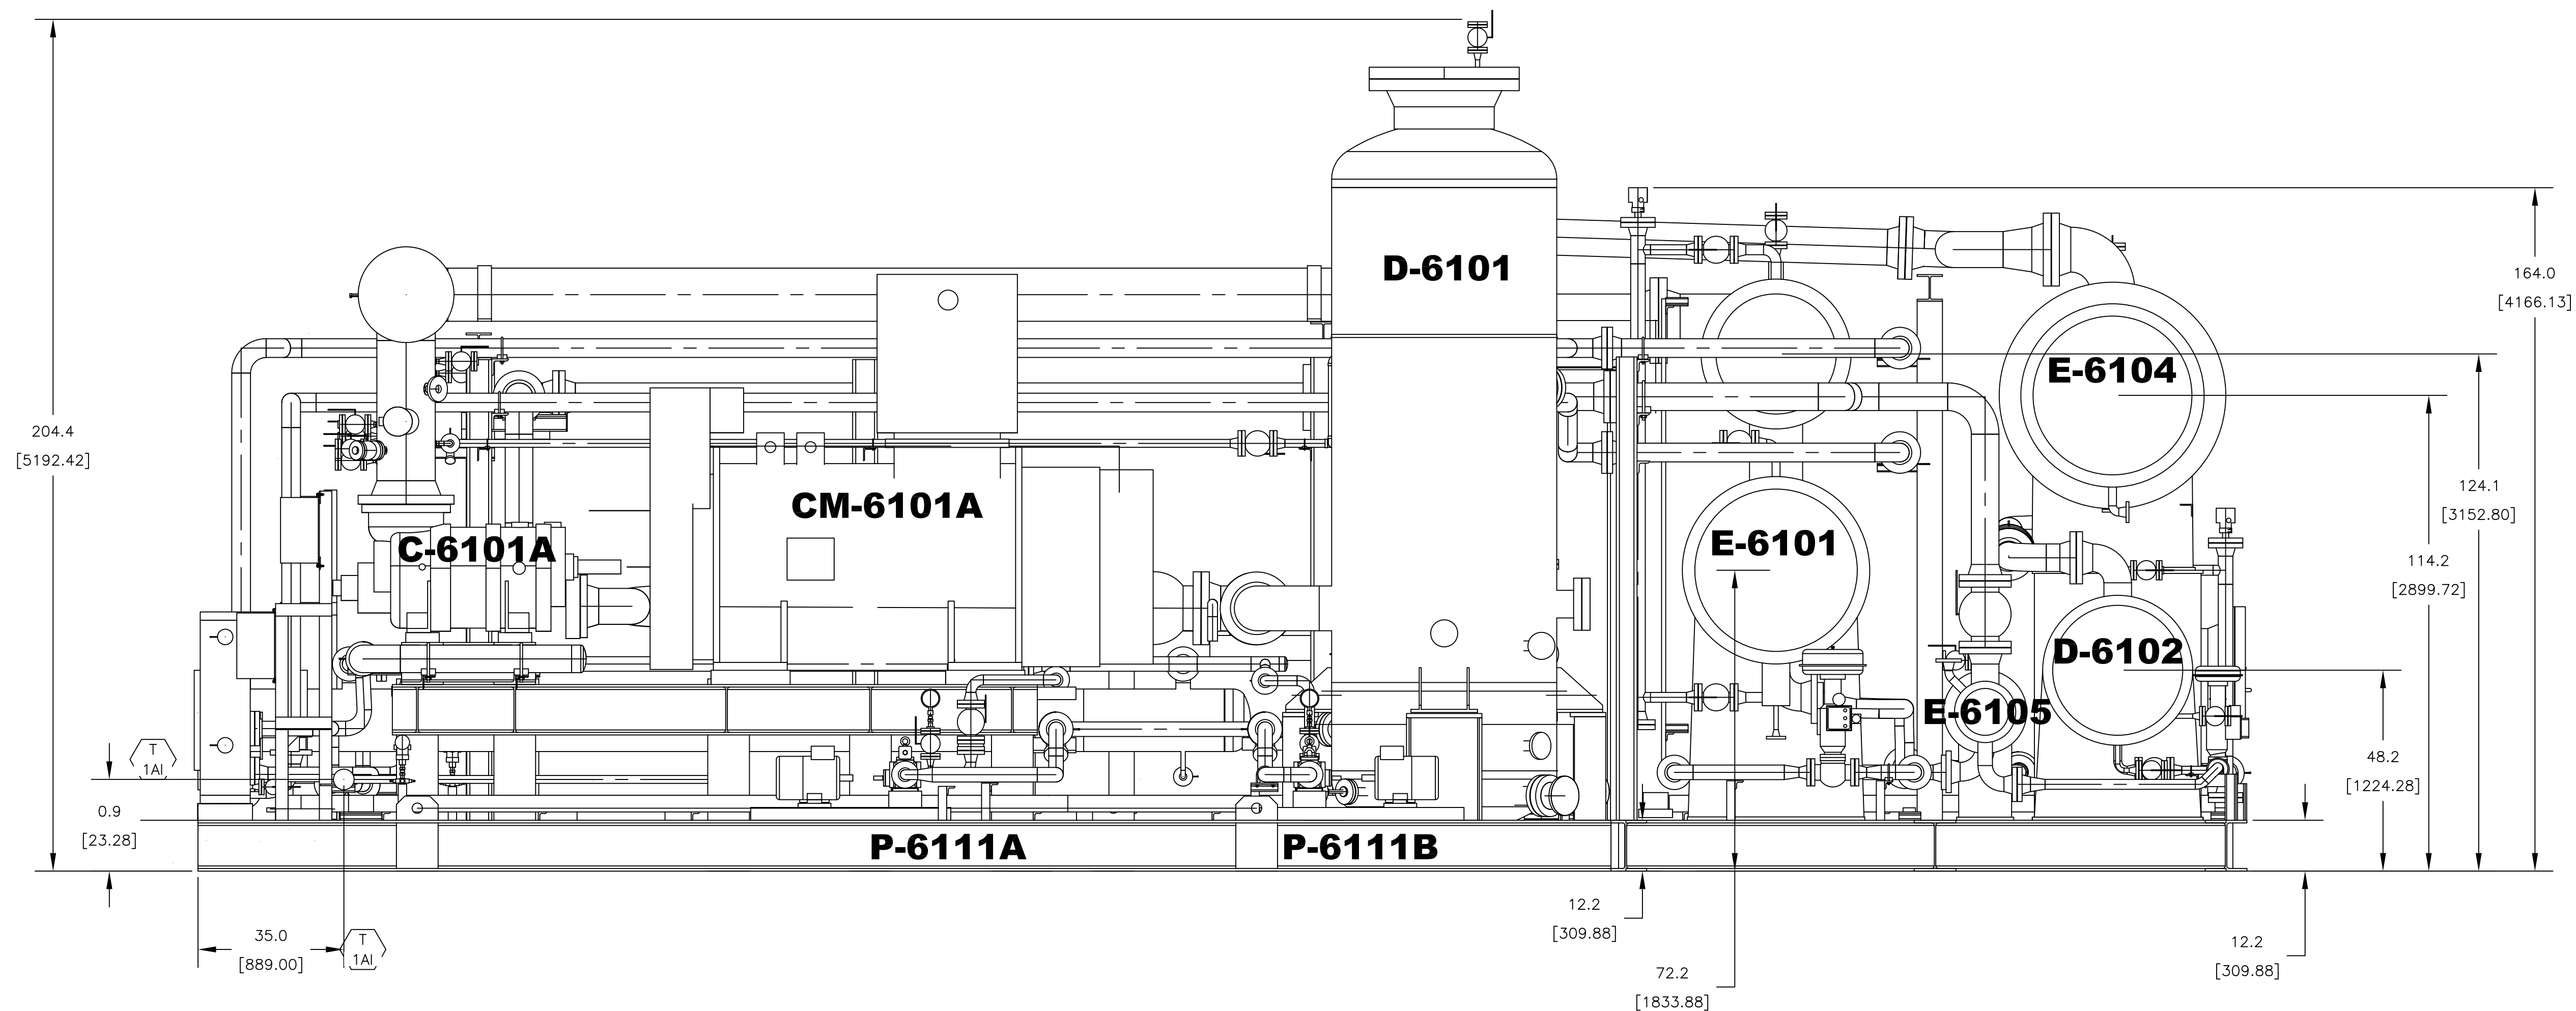

FRONT VIEW

Code1	<input type="checkbox"/> No Comment/ Approved (Applicable Only for "FOR REVIEW" and "For Approval" Documents) No comment and the document are released for Manufacturing				
Code2	<input type="checkbox"/> No Comment / Approved with Note(s) Vendor/Sub-Contractor shall correct, revise and resubmit the document. The document is released for Manufacturing if changes incorporated.				
Code3	<input type="checkbox"/> Commented Vendor/Sub-Contractor shall correct, revise and resubmit the document by the date specified. The document shall be revised under the Status of "R: Revised Issue". All corrected documents shall be resubmitted before starting the Manufacturing Process				
Code4	<input type="checkbox"/> Not Accepted (Rejected) Vendor/Sub-Contractor shall re-work/re-design/re-specify the contents of the document according to the comments/reasons for rejection. All corrected documents shall be resubmitted before starting the manufacturing. Vendor/Sub-Contractor shall not proceed with subsequent work of Material Supply or Manufacturing until receiving Code1/Code2 or No Code from PURCHASER. Vendor/Sub-Contractor shall resubmit the document with the same revision within 6 working days after receiving comments				
No Code	<input type="checkbox"/> No Code (Only for "For Information" Documents and "As Built DWG's") Document has been submitted for PURCHASER's information (I). Consistency, completeness and correctness of document content is in Vendor/Sub-Contractor's responsibility. The above checking result by EIED shall in no way relieve Vendor of any liability, obligation and responsibility out of the purchase order and the mutual agreement in writing				
DATE : DEPT : Signature :					
CV	PI	EL	IN	ME	MA
ST	BU	PR	SA	HV	TL

02	09.10.2025	IFR	FA	IM	OG
01	16.09.2025	IFR	FA	IM	OG
00	28.06.2025	IFR	FA	IM	OG
REV.	DATE (dd.MM.YY)	Purpose of Issue	Prepared	Checked	Approved
		Gachasan Polymer Industries Company HDPE Plant			
PO No.: GPIC-PT-MA-PO-000-3029					SCALE: 1/2":1'
DRAWING TITLE: General Arrangement Drawing (2D) (*Tie-In Points , Skid Dimensions & Orientation, Including Instrument, Junction Box and Local Panel Location Layout & Instrument Cable routing.) for Refrinerator Parkane					
DRAWING NO. VD-GPIC-MA-3029-3029-0062		REV.	SHEET NO.	SIZE	
		02	4	OF 11	A1

A		B		C		D	
CONNECTION LIST							
NO.	LOCATION	DESCRIPTION	SIZE				
T-1AI	COMPRESSOR SKID-A	INSTRUMENT AIR SUPPLY	1"-150 ANSI RF				
T-2AI	COMPRESSOR SKID-B	INSTRUMENT AIR SUPPLY	1"-150 ANSI RF				
T-4AI	VESSEL SKID	INSTRUMENT AIR SUPPLY	1"-150 ANSI RF				
T-4CWS	VESSEL SKID	OIL COOLER COOLING WATER SUPPLY	8"-300 ANSI RF				
T-4CWR	VESSEL SKID	OIL COOLER COOLING WATER RETURN	8"-300 ANSI RF				
T-41	VESSEL SKID	FILTER/DRYER INLET	1-1/2"-300 ANSI RF				
T-51	VESSEL SKID	CHILLER PROCESS INLET	14"-300 ANSI RF				
T-52	VESSEL SKID	CHILLER PROCESS OUTLET	14"-300 ANSI RF				
S-31	COMPRESSOR SKID-A	OIL SEPARATOR PRESSURE SAFETY	4"-300 ANSI RF				
S-41	VESSEL SKID	CONDENSER PRESSURE SAFETY	3"-300 ANSI RF				
S-42	VESSEL SKID	RECEIVER PRESSURE SAFETY	4"-300 ANSI RF				
S-43	VESSEL SKID	ECONOMIZER PRESSURE SAFETY-SHELL	1-1/2"-300 ANSI RF				
S-44	VESSEL SKID	ECONOMIZER PRESSURE SAFETY-TUBE	1-1/2"-300 ANSI RF				
S-51	VESSEL SKID	CHILLER PRESSURE SAFETY	3"-300 ANSI RF				


EQUIPMENT TAG NUMBER	
TAG NO.	DESCRIPTION
C-6101A	COMPRESSOR
C-6101B	COMPRESSOR
CM-6101A	COMPRESSOR MOTOR
CM-6101B	COMPRESSOR MOTOR
E-6101	CHILLER
E-6102	OIL COOLER
E-6104	CONDENSER
E-6105	ECONOMIZER
D-6101	OIL SEPARATOR
D-6102	RECEIVER
P-6111A/A	OIL PUMPS
PM-6111A/A	OIL PUMP MOTORS

PR-01: PLEASE ADD OIL FILTER AND FILTER DRYER

EL01 (Repeated):
 1) Local Panel and junction boxes shall be numbered and displayed in a table with tags.
 2) All earth lugs shall be clearly identified.
 Moreover, an earth bar shall be installed on the skid, and all equipment earth conductors shall be connected to it.
 (These two items have been accepted in the vendor reply sheet but have not been implemented in this document.)

PR-02: IT CAN BE FINALIZED AFTER SIZING OF PSV INLETS

The size of tags (TI inlets) shall be specified in this view.

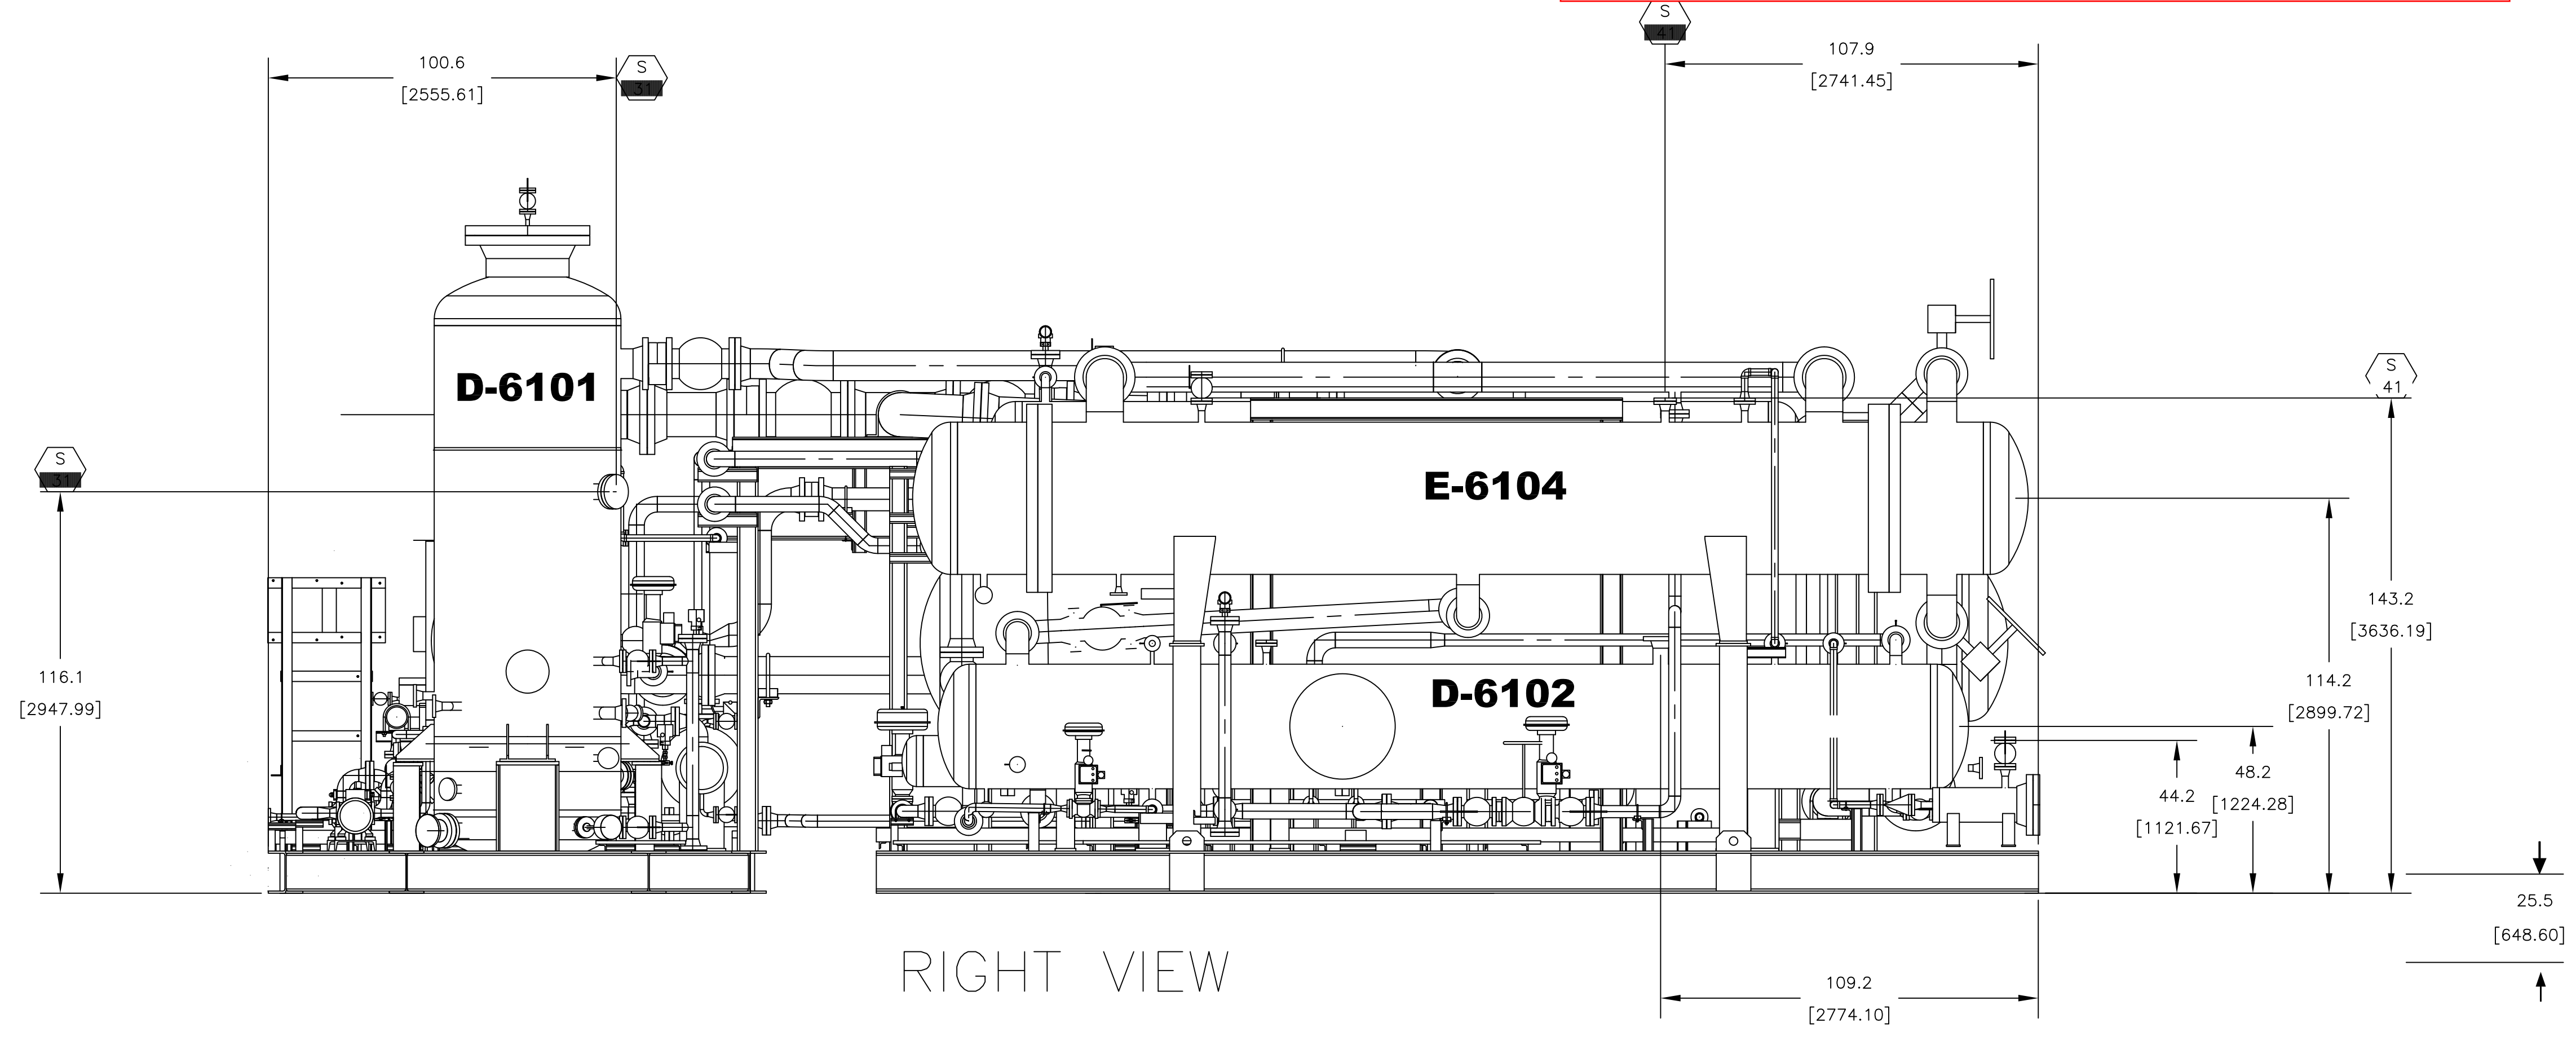

Code1	<input type="checkbox"/> No Comment / Approved (Applicable Only for "FOR REVIEW" and "For Approval" Documents) No comment and the document are released for Manufacturing
Code2	<input type="checkbox"/> No Comment / Approved with Note(s) Vendor/Sub-Contractor shall correct, revise and resubmit the document. The document is released for Manufacturing if changes incorporated.
Code3	<input type="checkbox"/> Commented Vendor/Sub-Contractor shall correct, revise and resubmit the document by the date specified. The document shall be revised under the Status of "R: Revised Issue". All corrected documents shall be resubmitted before starting the Manufacturing Process
Code4	<input type="checkbox"/> Not Accepted (Rejected) Vendor/Sub-Contractor shall re-work/re-design/re-specify the contents of the document according to the comments/reasons for rejection. All corrected documents shall be resubmitted before starting the manufacturing. Vendor Sub-Contractor shall not proceed with subsequent work of Material Supply or Manufacturing until receiving Code1/Code2 or No Code from PURCHASER. Vendor/Sub-Contractor shall resubmit the document with the same revision within 6 working days after receiving comments
No Code	<input type="checkbox"/> No Code (Only for "For Information" Documents and "As Built DWGs") Document has been submitted for PURCHASER'S information (I). Consistency, completeness and correctness of document content is in Vendor/Sub-Contractor's responsibility.


The above checking result by EIED shall in no way relieve Vendor of any liability, obligation and responsibility out of the purchase order and the mutual agreement in writing

DATE :
DEPT :
Signature :
CV PR EL IN ME MA
ST BU PR SA HV TL

02	09.10.2025	IFR	FA	IM	OG
01	16.09.2025	IFR	FA	IM	OG
00	28.06.2025	IFR	FA	IM	OG
REV.	DATE (DD.MM.YY)	Purpose of Issue	Prepared	Checked	Approved

PO No.: GPIC-PT-MA-PO-000-3029
 DRAWING TITLE: General Arrangement Drawing (2D) ("Tie-In Points", Skid Dimensions & Orientation, Including Instrument, Junction Box and Local Panel Location Layout & Instrument Cable routing.) for Refrinerator Parkane
 DRAWING NO. VD-GPIC-MA-3029-3029-0062
 REV. 02 SHEET NO. 5 OF 11 SIZE A1

The set of tags (T) should be specified in this view.

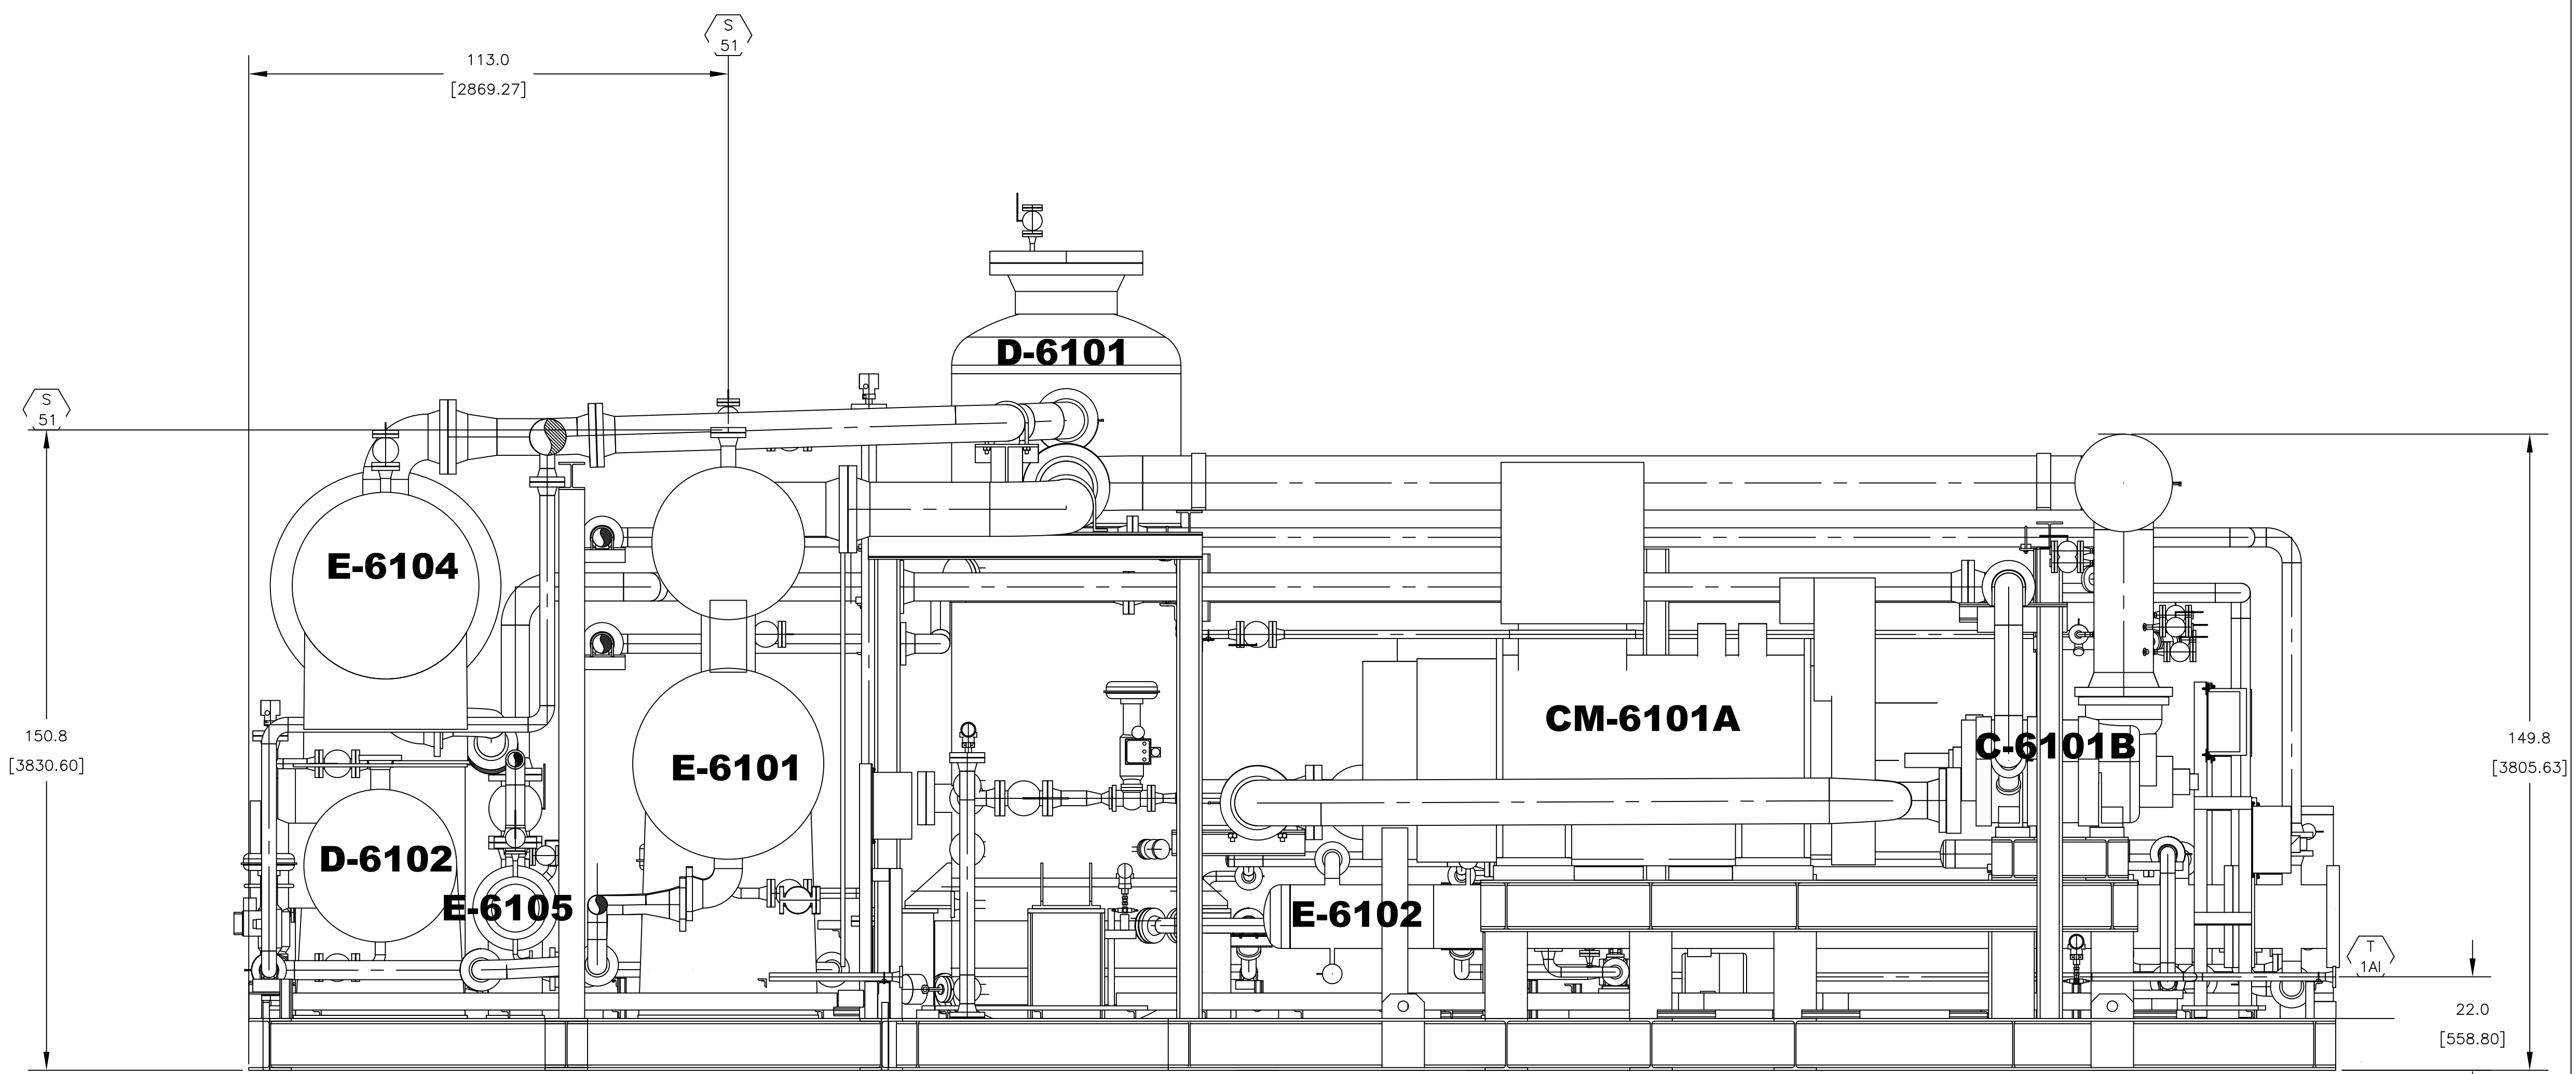

Code1	<input type="checkbox"/> No Comment / Approved (Applicable Only for "FOR REVIEW" and "For Approval" Documents) No comment and the document are released for Manufacturing
Code2	<input type="checkbox"/> No Comment / Approved with Note(s) Vendor/Sub-Contractor shall correct, revise and resubmit the document. The document is released for Manufacturing if changes incorporated.
Code3	<input type="checkbox"/> Commented Vendor/Sub-Contractor shall correct, revise and resubmit the document by the date specified. The document shall be revised under the Status of "R: Revised Issue". All corrected documents shall be resubmitted before starting the Manufacturing Process
Code4	<input type="checkbox"/> Not Accepted (Rejected) Vendor/Sub-Contractor shall re-work/re-design/re-specify the contents of the document according to the comments/reasons for rejection. All corrected documents shall be resubmitted before starting the manufacturing. Vendor Sub-Contractor shall not proceed with subsequent works of Material Supply or Manufacturing until receiving Code1/Code2 or No Code from PURCHASER. Vendor/Sub-Contractor shall resubmit the document with the same revision within 6 working days after receiving comments
No Code	<input type="checkbox"/> No Code (Only for "For Information" Documents and "As Built DWGs") Document has been submitted for PURCHASER's Information (I). Consistency, completeness and correctness of document content is in Vendor/Sub-Contractor's responsibility.



The above checking result by EIED shall in no way relieve Vendor of any liability, obligation and responsibility out of the purchase order and the mutual agreement in writing



EIED

DATE :
DEPT :
Signature :

CV	PI	EL	IN	ME	MA
ST	BU	PR	SA	HV	TL

02	09.10.2025	IFR	FA	IM	OG
01	16.09.2025	IFR	FA	IM	OG
00	28.06.2025	IFR	FA	IM	OG
REV.	DATE (dd.MM.YY)	Purpose of Issue	Prepared	Checked	Approved



Gachasan Polymer Industries Company
HDPE Plant





PO No.: GPIC-PT-MA-PO-000-3029 SCALE: 1/2":1'

BACK VIEW


DRAWING TITLE:
General Arrangement Drawing (2D) (Tie-In Points, Skid Dimensions & Orientation, Including Instrument, Junction Box and Local Panel Location Layout & Instrument Cable routing.) for Refrigerator Packane

DRAWING NO.	REV.	SHEET NO.	SIZE
VD-GPIC-MA-3029-3029-0062	02	6 OF 11	A1

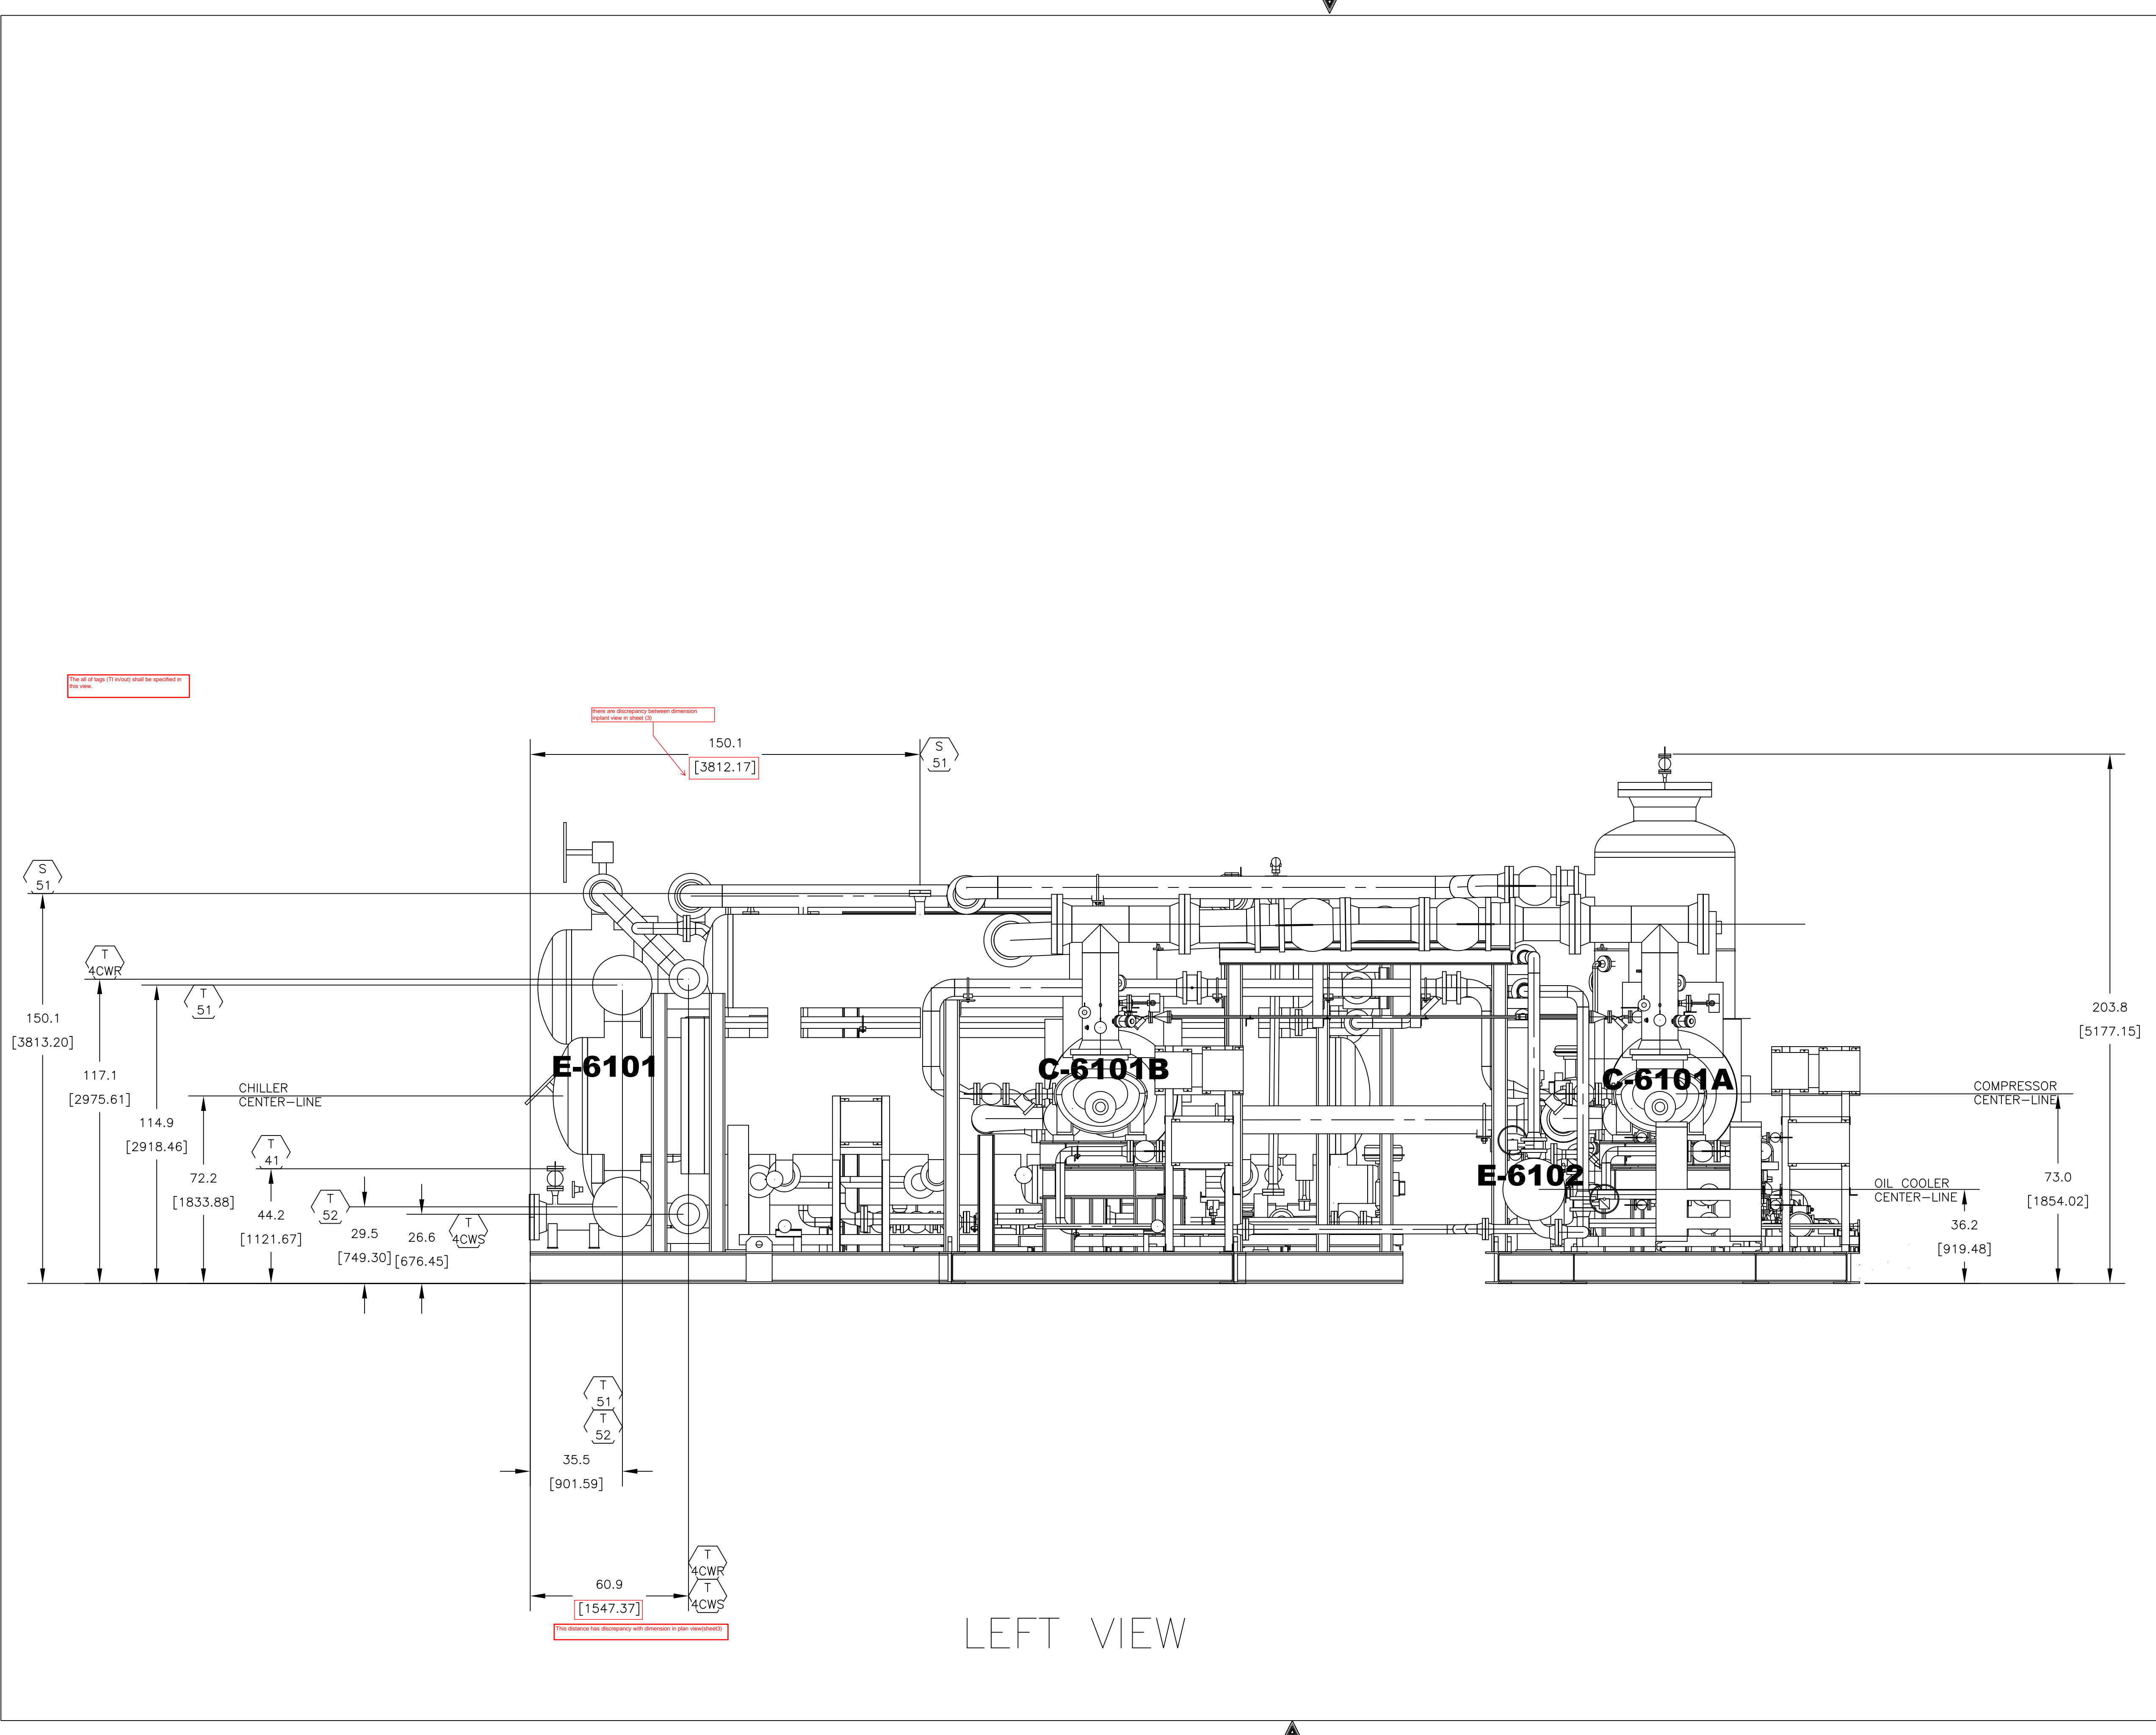

Code1	<input type="checkbox"/> No Comment/ Approved (Applicable Only for "FOR REVIEW" and "For Approval" Documents) No comment and the document are released for Manufacturing				
Code2	<input type="checkbox"/> No Comment / Approved with Note(s) Vendor/Sub-Contractor shall correct, revise and resubmit the document. The document is released for Manufacturing if changes incorporated.				
Code3	<input type="checkbox"/> Commented Vendor/Sub-Contractor shall correct, revise and resubmit the document by the date specified. The document shall be revised under the Status of "R: Revised Issue". All corrected documents shall be resubmitted before starting the Manufacturing Process				
Code4	<input type="checkbox"/> Not Accepted (Rejected) Vendor/Sub-Contractor shall re-work/re-design/re-specify the contents of the document according to the comments/reasons for rejection. All corrected documents shall be resubmitted before starting the manufacturing. Vendor/Sub-Contractor shall not proceed with subsequent work of Material Supply or Manufacturing until receiving Code1/Code2 or No Code from PURCHASER. Vendor/Sub-Contractor shall resubmit the document with the same revision within 6 working days after receiving comments				
No Code	<input type="checkbox"/> No Code (Only for "For Information" Documents and "As Built DWGs") Document has been submitted for PURCHASER'S Information (FI). Consistency, completeness and correctness of document content is in Vendor/Sub-Contractor's responsibility. The above checking result by EIED shall in no way relieve Vendor of any liability, obligation and responsibility out of the purchase order and the mutual agreement in writing				
DATE :					
DEPT:					
Signature :					
CV	PI	EL	IN	ME	MA
ST	BU	PR	SA	HV	TL

02	09.10.2025	IFR	FA	IM	OG
01	16.09.2025	IFR	FA	IM	OG
00	28.06.2025	IFR	FA	IM	OG
REV.	DATE (DD.MM.YY)	Purpose of Issue	Prepared	Checked	Approved
Gachasan Polymer Industries Company		Gachasan Plyomer Industries Company		HDPE Plant	
PO No.: GPIC-PT-MA-PO-000-3029				SCALE: 3/8":1'	
DRAWING TITLE: General Arrangement Drawing (2D) ("Tie-In Points, Skid Dimensions & Orientation, Including Instrument, Junction Box and Local Panel Location Layout & Instrument Cable routing.) for Refrigerator Package					
DRAWING NO.	VD-GPIC-MA-3029-3029-0062	REV.	SHEET NO.	SIZE	
		02	7 OF 11	A1	

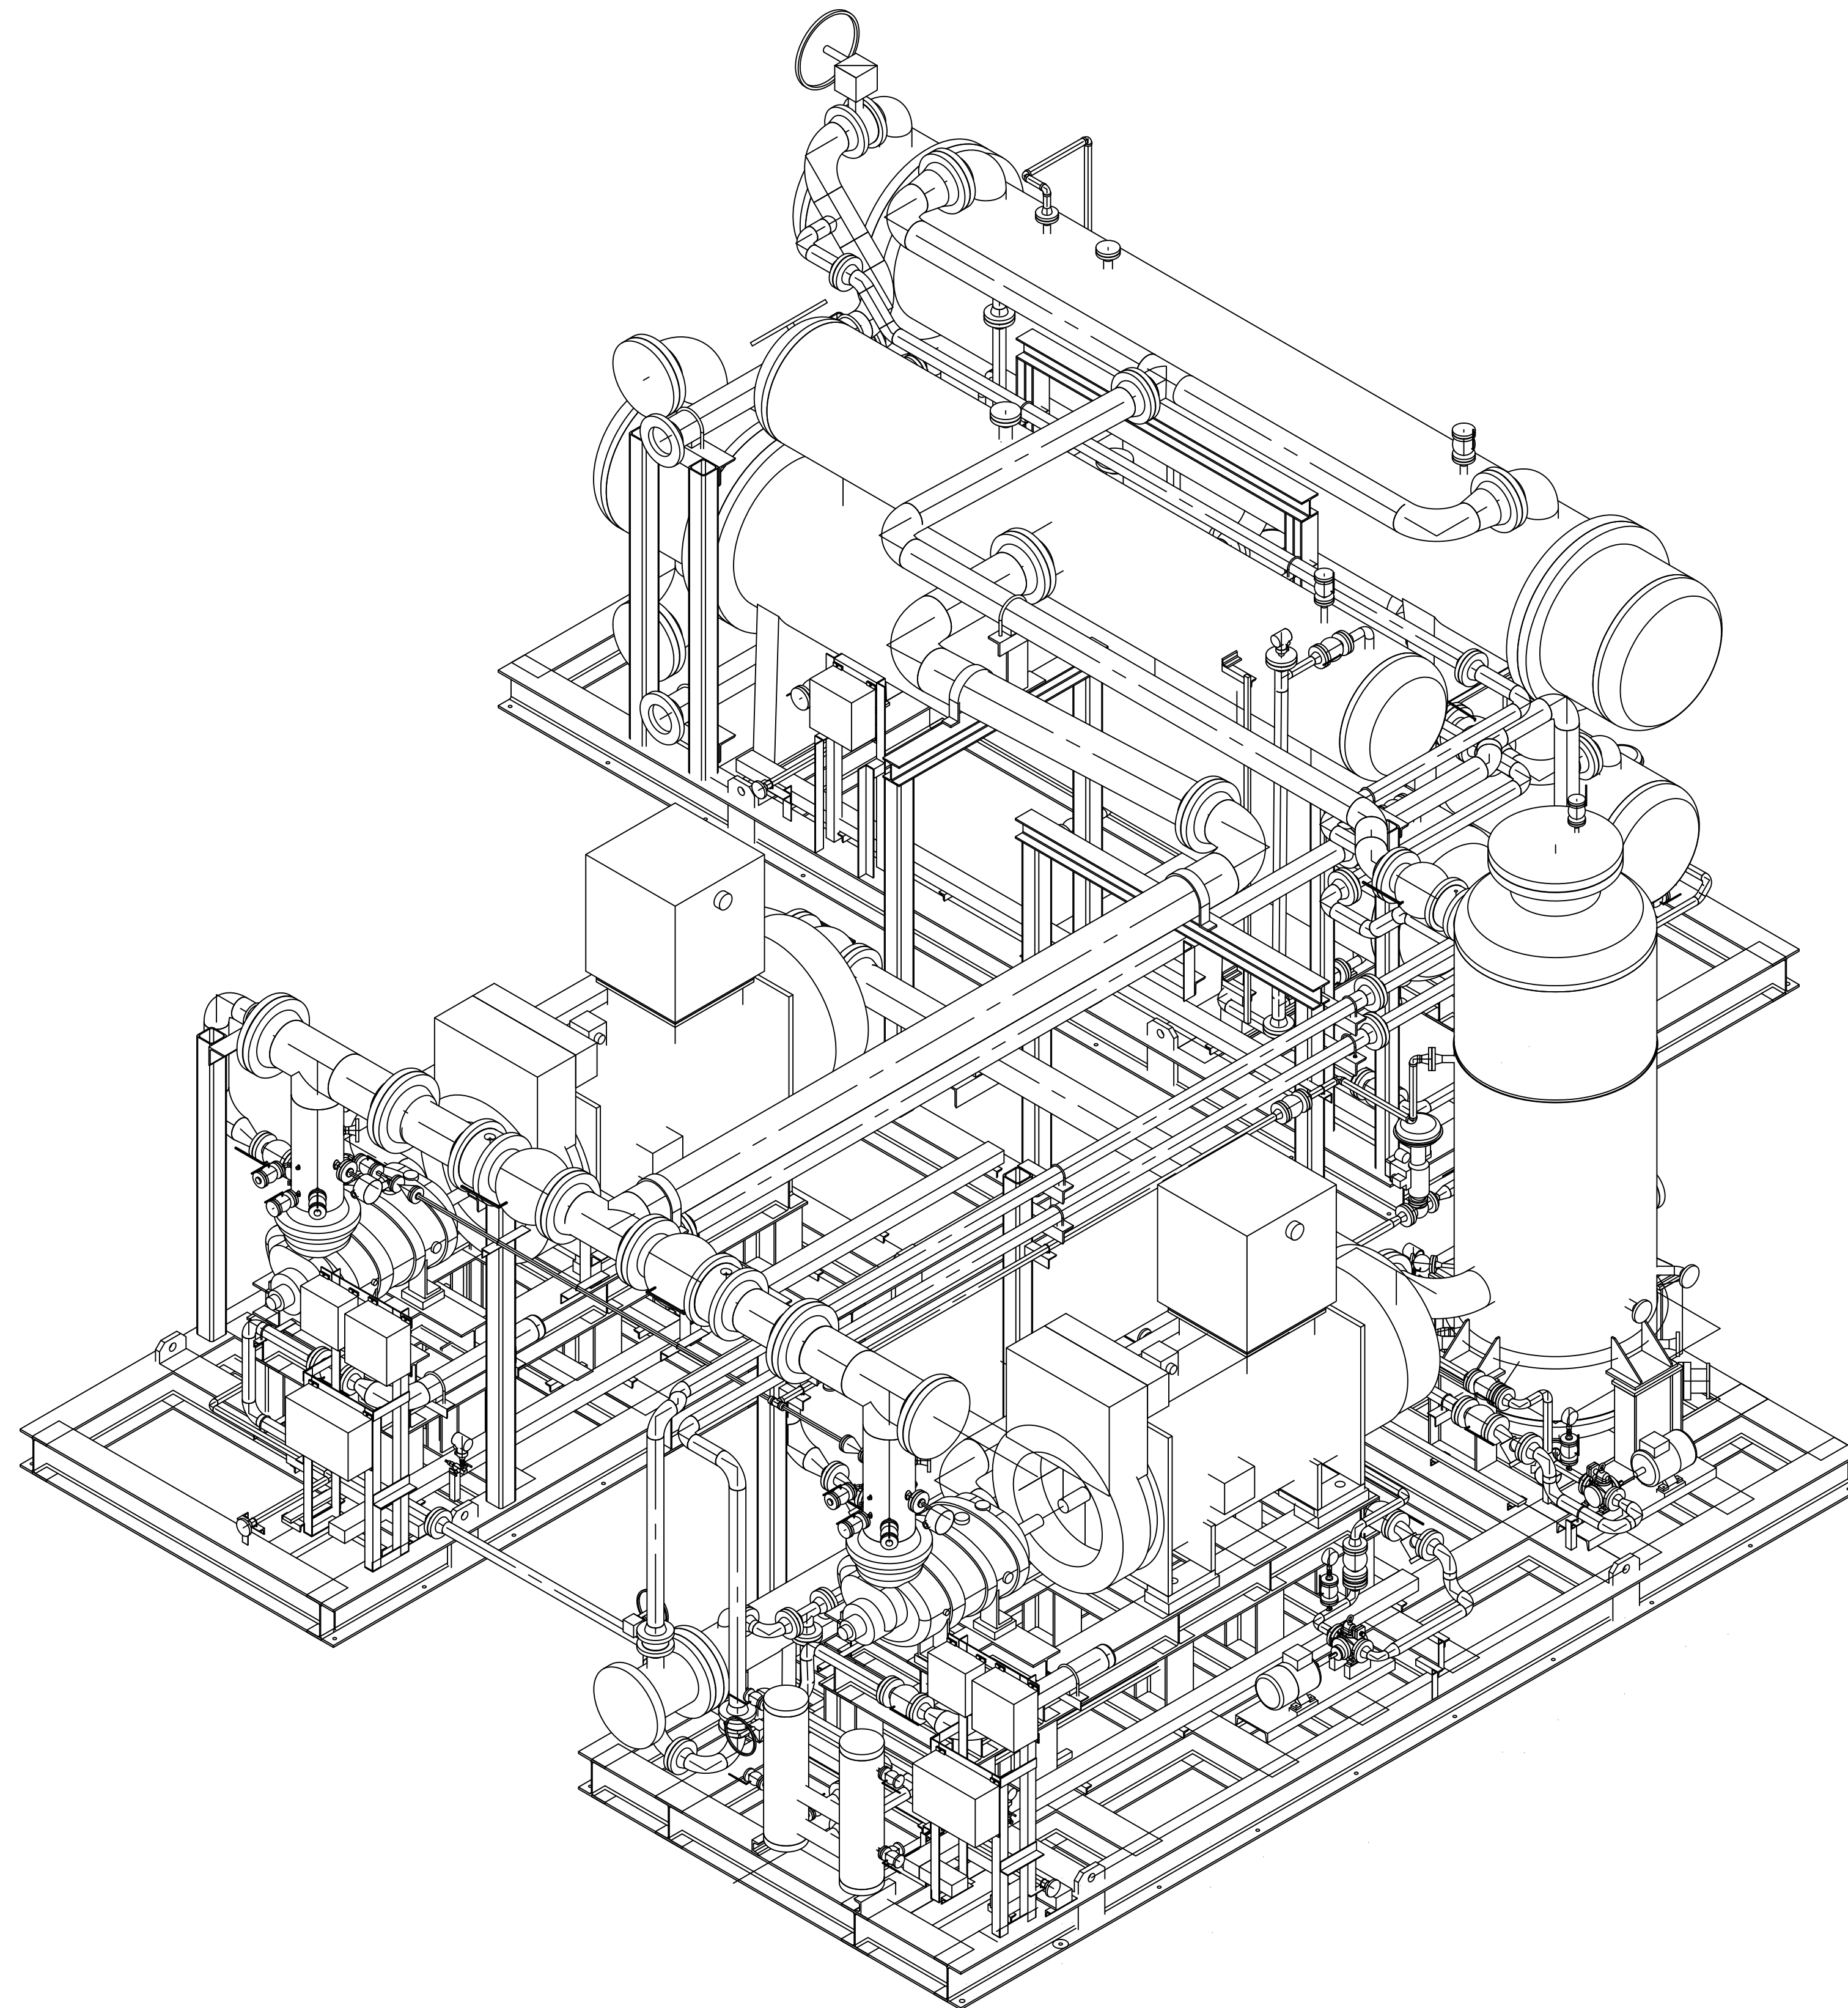

Code1 No Comment/ Approved
(Applicable Only for "FOR REVIEW" and "For Approval" Documents) No comment and the document are released for Manufacturing

Code2 No Comment / Approved with Note(s)
Vendor/Sub-Contractor shall correct, revise and resubmit the document. The document is released for Manufacturing if changes incorporated.

Code3 Commented
Vendor/Sub-Contractor shall correct, revise and resubmit the document by the date specified. The document shall be revised under the Status of "R: Revised Issue". All corrected documents shall be resubmitted before starting the Manufacturing Process

Code4 Not Accepted (Rejected)
Vendor/Sub-Contractor shall re-work/re-design/re-specify the contents of the document according to the comments/reasons for rejection. All corrected documents shall be resubmitted before starting the manufacturing Vendor Sub-Contractor shall not proceed with subsequent works of Material Supply or Manufacturing until receiving Code1/Code2 or No Code from PURCHASER. Vendor/Sub-Contractor shall resubmit the document with the same revision within 6 working days after receiving comments

No Code No Code
(Only for "For Information" Documents and "As Built DWG's") Document has been submitted for PURCHASER's Information (I). Consistency, completeness and correctness of document content is in Vendor/Sub-Contractor's responsibility.

The above checking result by EIED shall in no way relieve Vendor of any liability, obligation and responsibility out of the purchase order and the mutual agreement in writing

EIED

DATE :
DEPT :
Signature :


CV	PI	EL	IN	ME	MA
ST	BU	PR	SA	HV	TL


02	09.10.2025	IFR	FA	IM	OG
01	16.09.2025	IFR	FA	IM	OG
00	28.06.2025	IFR	FA	IM	OG
REV.	DATE (DD.MM.YY)	Purpose of Issue	Prepared	Checked	Approved

		Gachasan Polymer Industries Company HDPE Plant		
PO No.: GPIC-PT-MA-PO-000-3029			SCALE: 3/8":1'	



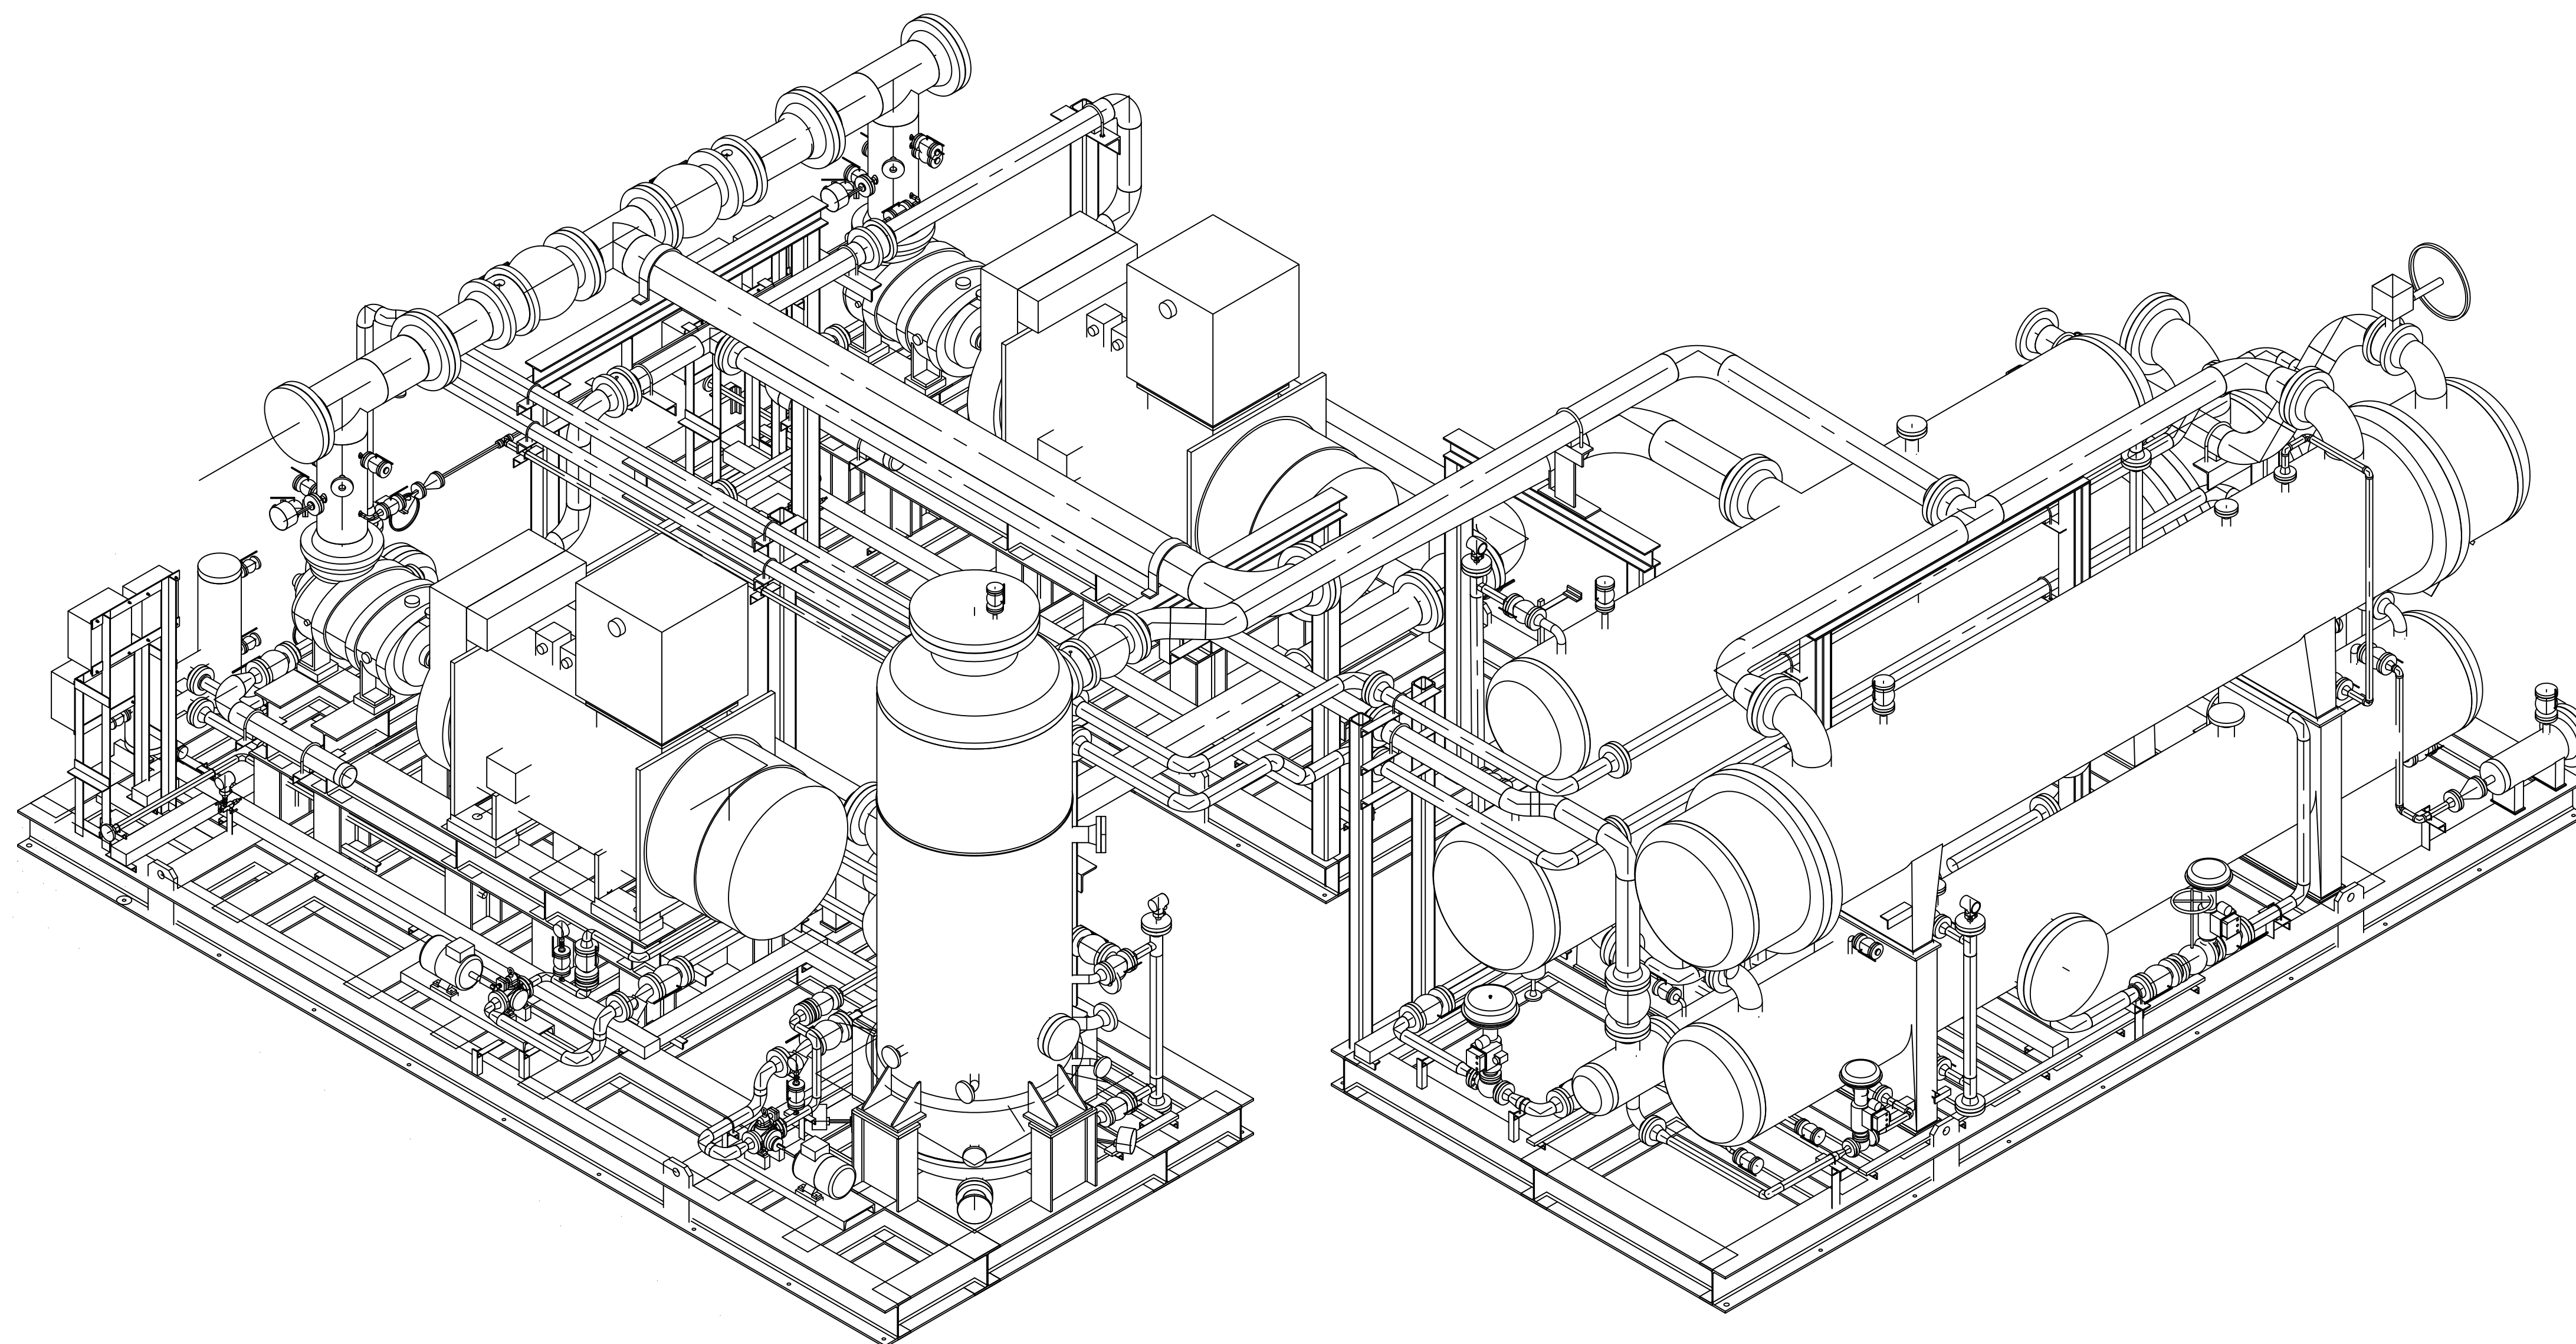

DRAWING TITLE:
General Arrangement Drawing (2D) (*Tie-In Points , Skid Dimensions & Orientation, Including Instrument, Junction Box and Local Panel Location Layout & Instrument Cable routing.)
for Refrigerator Packane


DRAWING NO.	VD-GPIC-MA-3029-3029-0062	REV.	SHEET NO.	SIZE
		02	8 OF 11	A1



Code1	<input type="checkbox"/> No Comment/ Approved (Applicable Only for "FOR REVIEW" and "For Approval" Documents) No comment and the document are released for Manufacturing				
Code2	<input type="checkbox"/> No Comment / Approved with Note(s) Vendor/Sub-Contractor shall correct, revise and resubmit the document. The document is released for Manufacturing if changes incorporated.				
Code3	<input type="checkbox"/> Commented Vendor/Sub-Contractor shall correct, revise and resubmit the document by the date specified. The document shall be revised under the Status of "R: Revised Issue". All corrected documents shall be resubmitted before starting the Manufacturing Process				
Code4	<input type="checkbox"/> Not Accepted (Rejected) Vendor/Sub-Contractor shall re-work/re-design/re-specify the contents of the document according to the comments/reasons for rejection. All corrected documents shall be resubmitted before starting the manufacturing. Vendor Sub-Contractor shall not proceed with subsequent works of Material Supply or Manufacturing until receiving Code1/Code2 or No Code from PURCHASER. Vendor/Sub-Contractor shall resubmit the document with the same revision within 6 working days after receiving comments				
No Code	<input type="checkbox"/> No Code (Only for "For Information" Documents and "As Built DWGs") Document has been submitted for PURCHASER'S information (I). Consistency, completeness and correctness of document content is in Vendor/Sub-Contractor's responsibility.				
The above checking result by EIED shall in no way relieve Vendor of any liability, obligation and responsibility out of the purchase order and the mutual agreement in writing					
 DATE : DEPT: Signature :					
CV	PI	EL	IN	ME	MA
ST	BU	PR	SA	HV	TL

02	09.10.2025	IFR	FA	IM	OG
01	16.09.2025	IFR	FA	IM	OG
00	28.06.2025	IFR	FA	IM	OG
REV.	DATE (DD.MM.YY)	Purpose of Issue	Prepared	Checked	Approved

 Gachasan Polymer Industries Company	 Gachasan Polymer Industries Company HDPE Plant	  DELTA PROCESS EQUIPMENT
PO No.: GPIC-PT-MA-PO-000-3029		SCALE: 3/8":1'
DRAWING TITLE: General Arrangement Drawing (2D) ("Tie-In Points , Skid Dimensions & Orientation, Including Instrument, Junction Box and Local Panel Location Layout & Instrument Cable routing.) for Refrigerator Packings		
DRAWING NO. VD-GPIC-MA-3029-3029-0062	REV. 02	SHEET NO. OF 11 SIZE A1

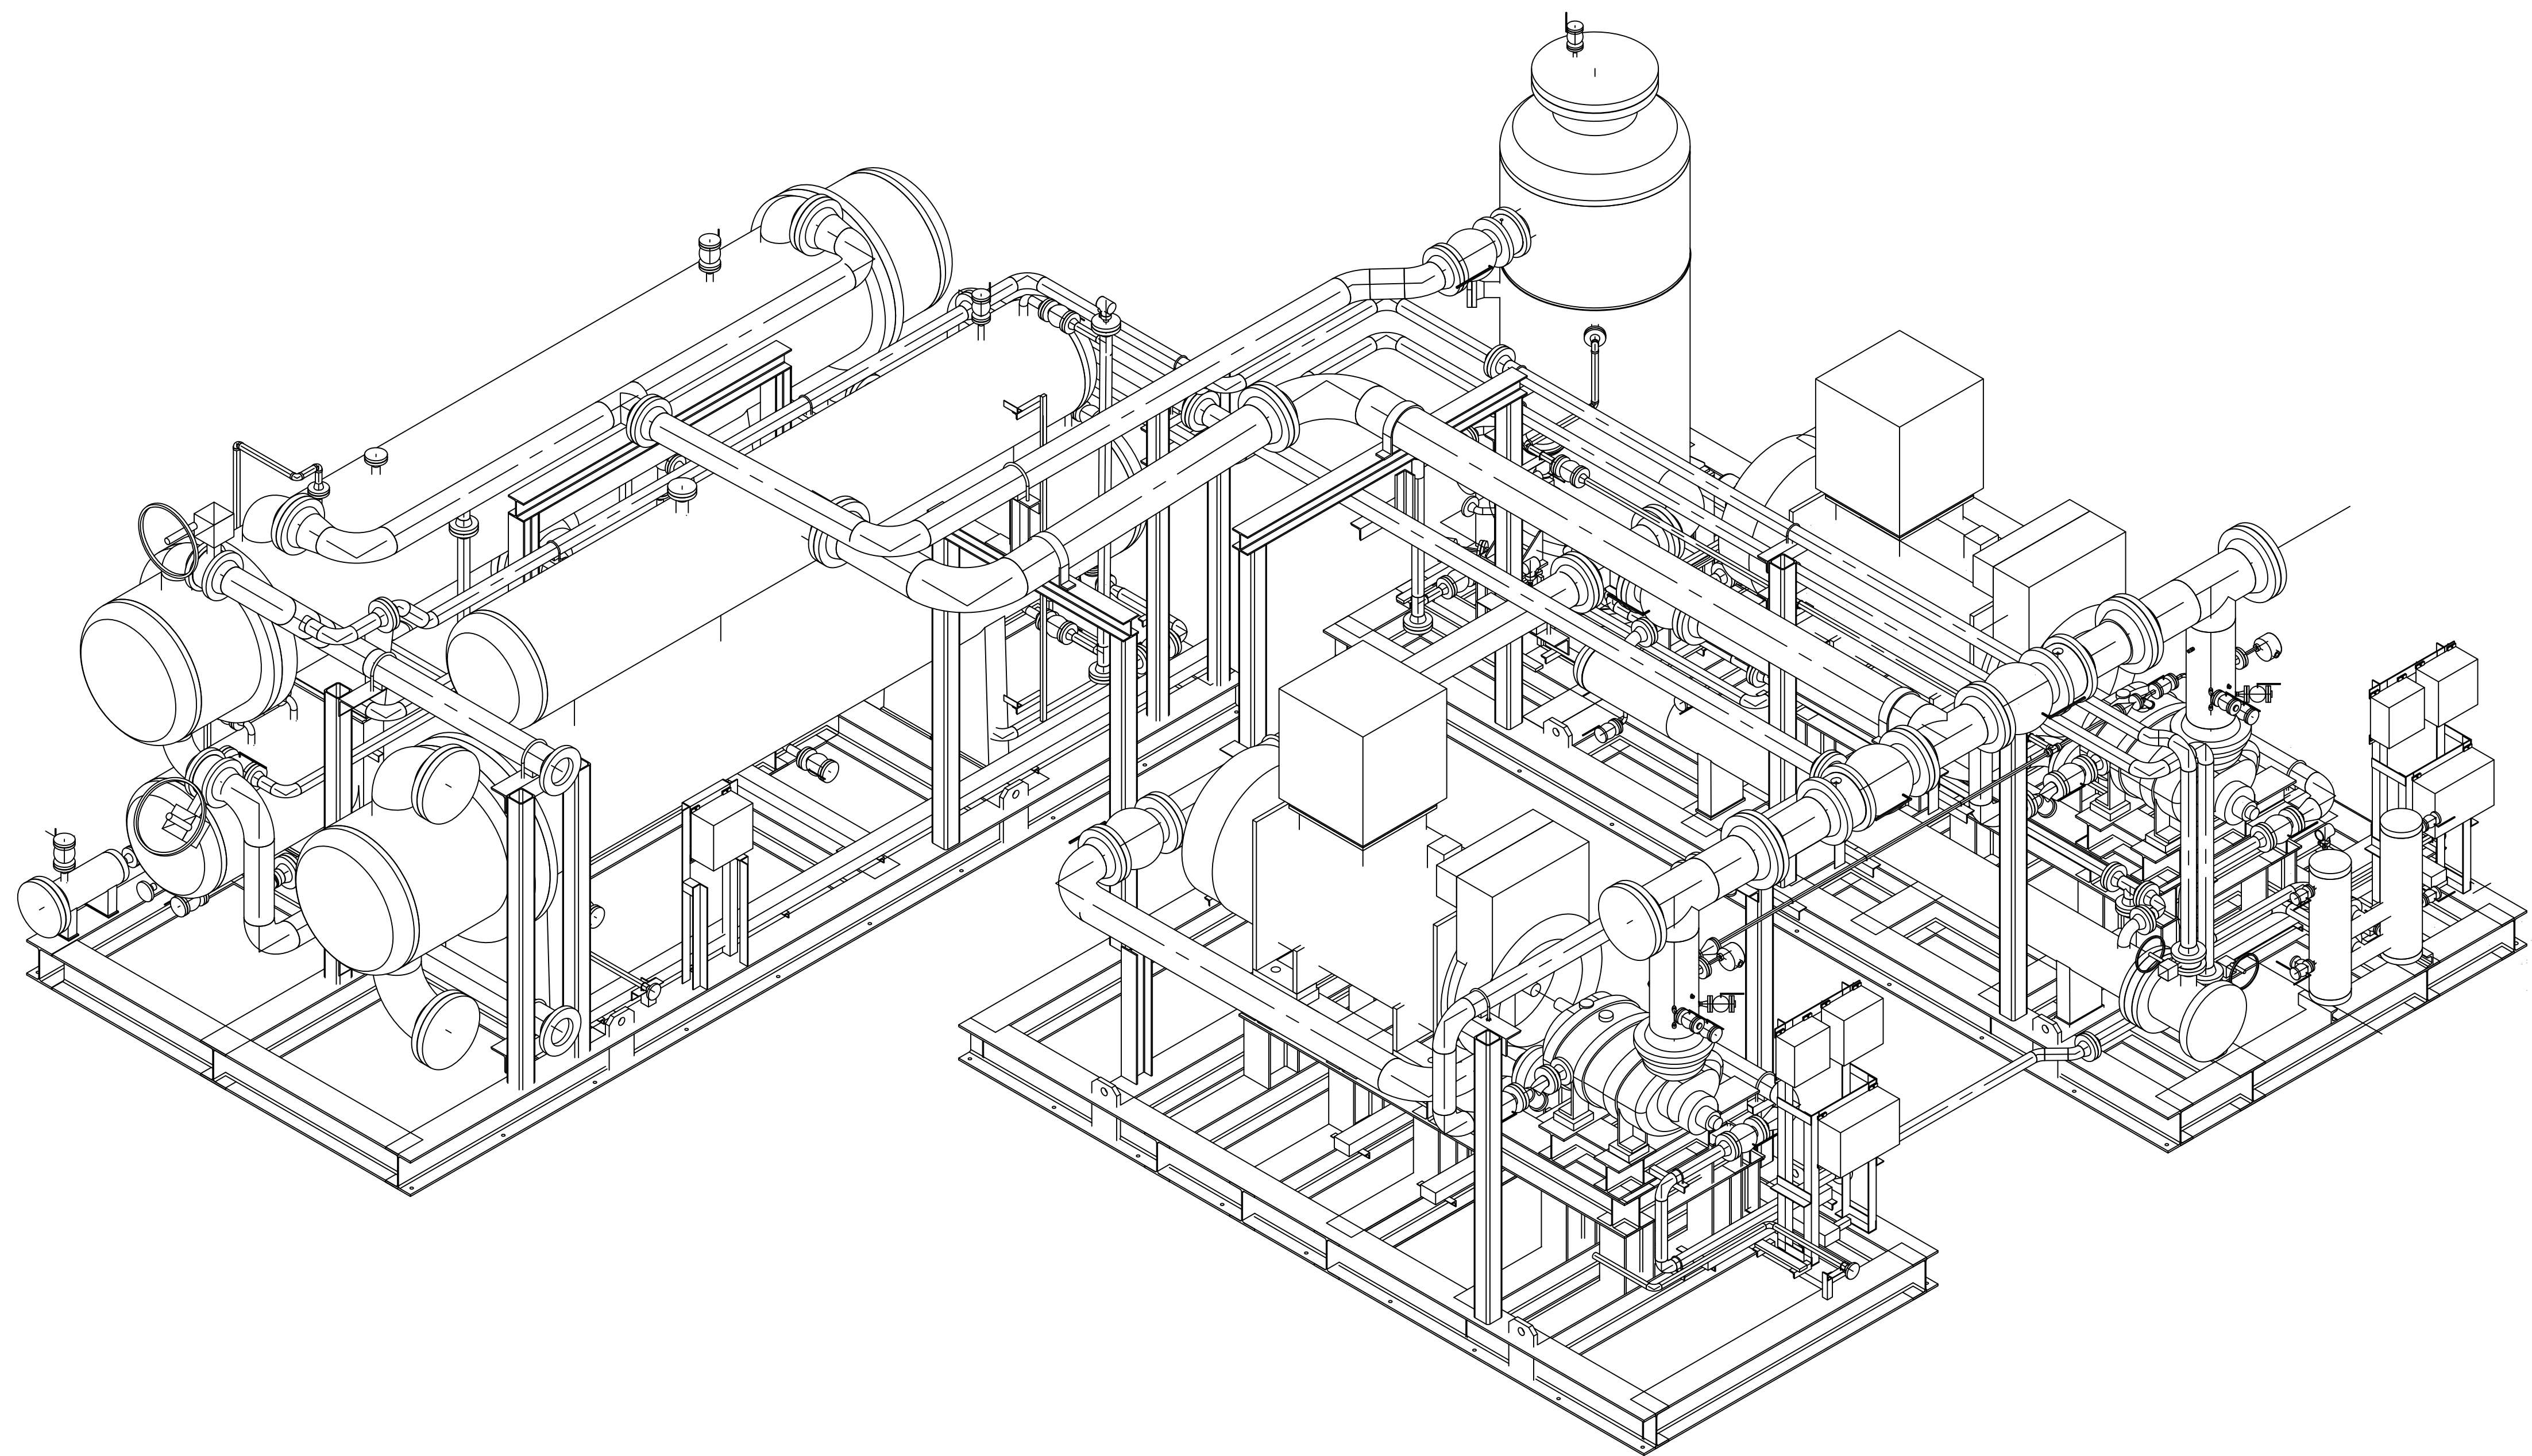

Code1	<input type="checkbox"/> No Comment/ Approved (Applicable Only for "FOR REVIEW" and "For Approval" Documents) No comment and the document are released for Manufacturing
Code2	<input type="checkbox"/> No Comment / Approved with Note(s) Vendor/Sub-Contractor shall correct, revise and resubmit the document. The document is released for Manufacturing if changes incorporated.
Code3	<input type="checkbox"/> Commented Vendor/Sub-Contractor shall correct, revise and resubmit the document by the date specified. The document shall be revised under the Status of "R: Revised Issue". All corrected documents shall be resubmitted before starting the Manufacturing Process
Code4	<input type="checkbox"/> Not Accepted (Rejected) Vendor/Sub-Contractor shall re-work/re-design/re-specify the contents of the document according to the comments/reasons for rejection. All corrected documents shall be resubmitted before starting the manufacturing. Vendor Sub-Contractor shall not proceed with subsequent work of Material Supply or Manufacturing until receiving Code1/Code2 or No Code from PURCHASER. Vendor/Sub-Contractor shall resubmit the document with the same revision within 6 working days after receiving comments
No Code	<input type="checkbox"/> No Code (Only for "For Information" Documents and "As Built DWGs") Document has been submitted for PURCHASER'S information (I). Consistency, completeness and correctness of document content is in Vendor/Sub-Contractor's responsibility.

The above checking result by EIED shall in no way relieve Vendor of any liability, obligation and responsibility out of the purchase order and the mutual agreement in writing

DATE :
DEPT :
Signature :

CV	PI	EL	IN	ME	MA
ST	BU	PR	SA	HV	TL


02	09.10.2025	IFR	FA	IM	OG
01	16.09.2025	IFR	FA	IM	OG
00	28.06.2025	IFR	FA	IM	OG
REV.	DATE (DD.MM.YY)	Purpose of Issue	Prepared	Checked	Approved

		Gachasan Plyomer Industries Company	
		HDPE Plant	

PO No.: GPIC-PT-MA-PO-000-3029 SCALE: 3/8":1'

DRAWING TITLE:
General Arrangement Drawing (2D) (*Tie-In Points , Skid Dimensions & Orientation, Including Instrument, Junction Box and Local Panel Location Layout & Instrument Cable routing.)
for Refrinerator Parkane

DRAWING NO.	VD-GPIC-MA-3029-3029-0062	REV.	SHEET NO.	SIZE
		02	10 OF 11	A1

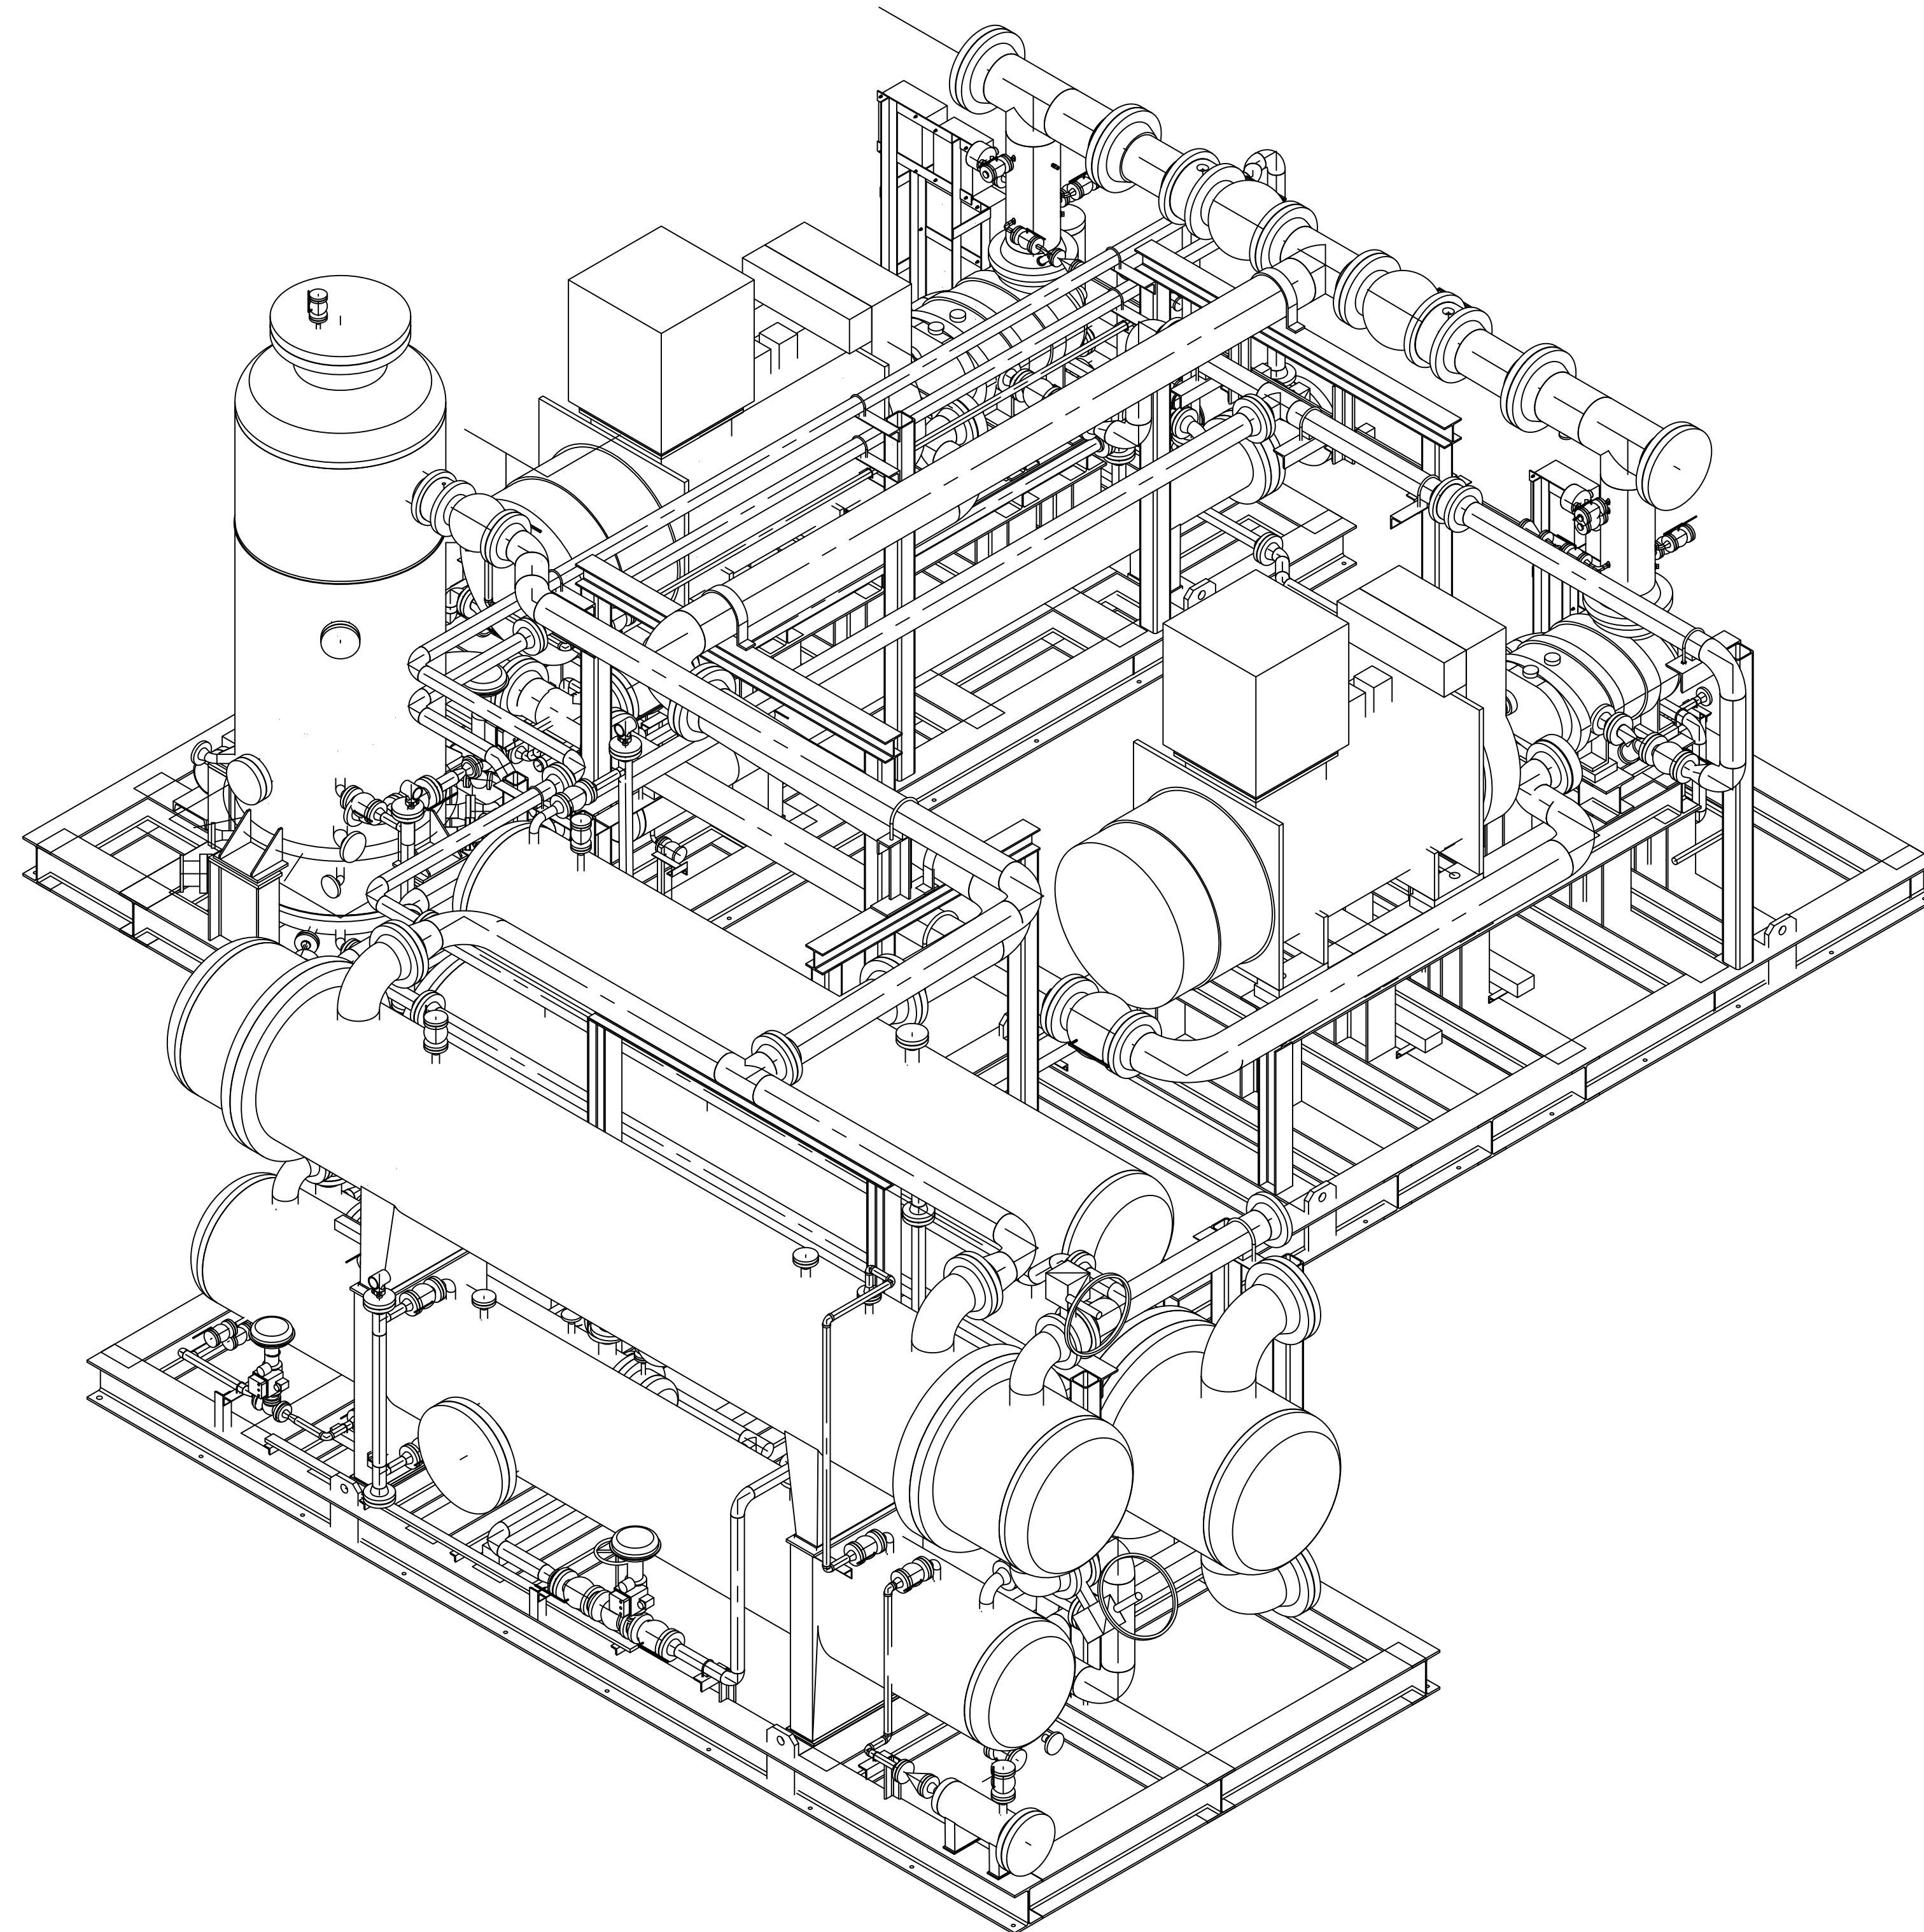

Code1	<input type="checkbox"/> No Comment/ Approved (Applicable Only for "FOR REVIEW" and "For Approval" Documents) No comment and the document are released for Manufacturing
Code2	<input type="checkbox"/> No Comment / Approved with Note(s) Vendor/Sub-Contractor shall correct, revise and resubmit the document. The document is released for Manufacturing if changes incorporated.
Code3	<input type="checkbox"/> Commented Vendor/Sub-Contractor shall correct, revise and resubmit the document by the date specified. The document shall be revised under the Status of "R: Revised Issue". All corrected documents shall be resubmitted before starting the Manufacturing Process
Code4	<input type="checkbox"/> Not Accepted (Rejected) Vendor/Sub-Contractor shall re-work/re-design/re-specify the contents of the document according to the comments/reasons for rejection. All corrected documents shall be resubmitted before starting the manufacturing. Vendor Sub-Contractor shall not proceed with subsequent works of Material Supply or Manufacturing until receiving Code1/Code2 or No Code from PURCHASER. Vendor/Sub-Contractor shall resubmit the document with the same revision within 6 working days after receiving comments
No Code	<input type="checkbox"/> No Code (Only for "For Information" Documents and "As Built DWGs") Document has been submitted for PURCHASER'S information (I). Consistency, completeness and correctness of document content is in Vendor/Sub-Contractor's responsibility.

The above checking result by EIED shall in no way relieve Vendor of any liability, obligation and responsibility out of the purchase order and the mutual agreement in writing

EIED

DATE :
DEPT :
Signature :

CV	PI	EL	IN	ME	MA
ST	BU	PR	SA	HV	TL

02	09.10.2025	IFR	FA	IM	OG
01	16.09.2025	IFR	FA	IM	OG
00	28.06.2025	IFR	FA	IM	OG
REV.	DATE (DD.MM.YY)	Purpose of Issue	Prepared	Checked	Approved

		Gacharan Polymer Industries Company HDPE Plant		
--	--	---	--	--

PO No.: GPIC-PT-MA-PO-000-3029 SCALE: 3/8":1'

DRAWING TITLE:
General Arrangement Drawing (2D) ("Tie-In Points - Skid Dimensions & Orientation, Including Instrument, Junction Box and Local Panel Location Layout & Instrument Cable routing.)
for Refrigerator Parkane

DRAWING NO.	VD-GPIC-MA-3029-3029-0062	REV.	SHEET NO.	SIZE
		02	11 OF 11	A1