


NORTH

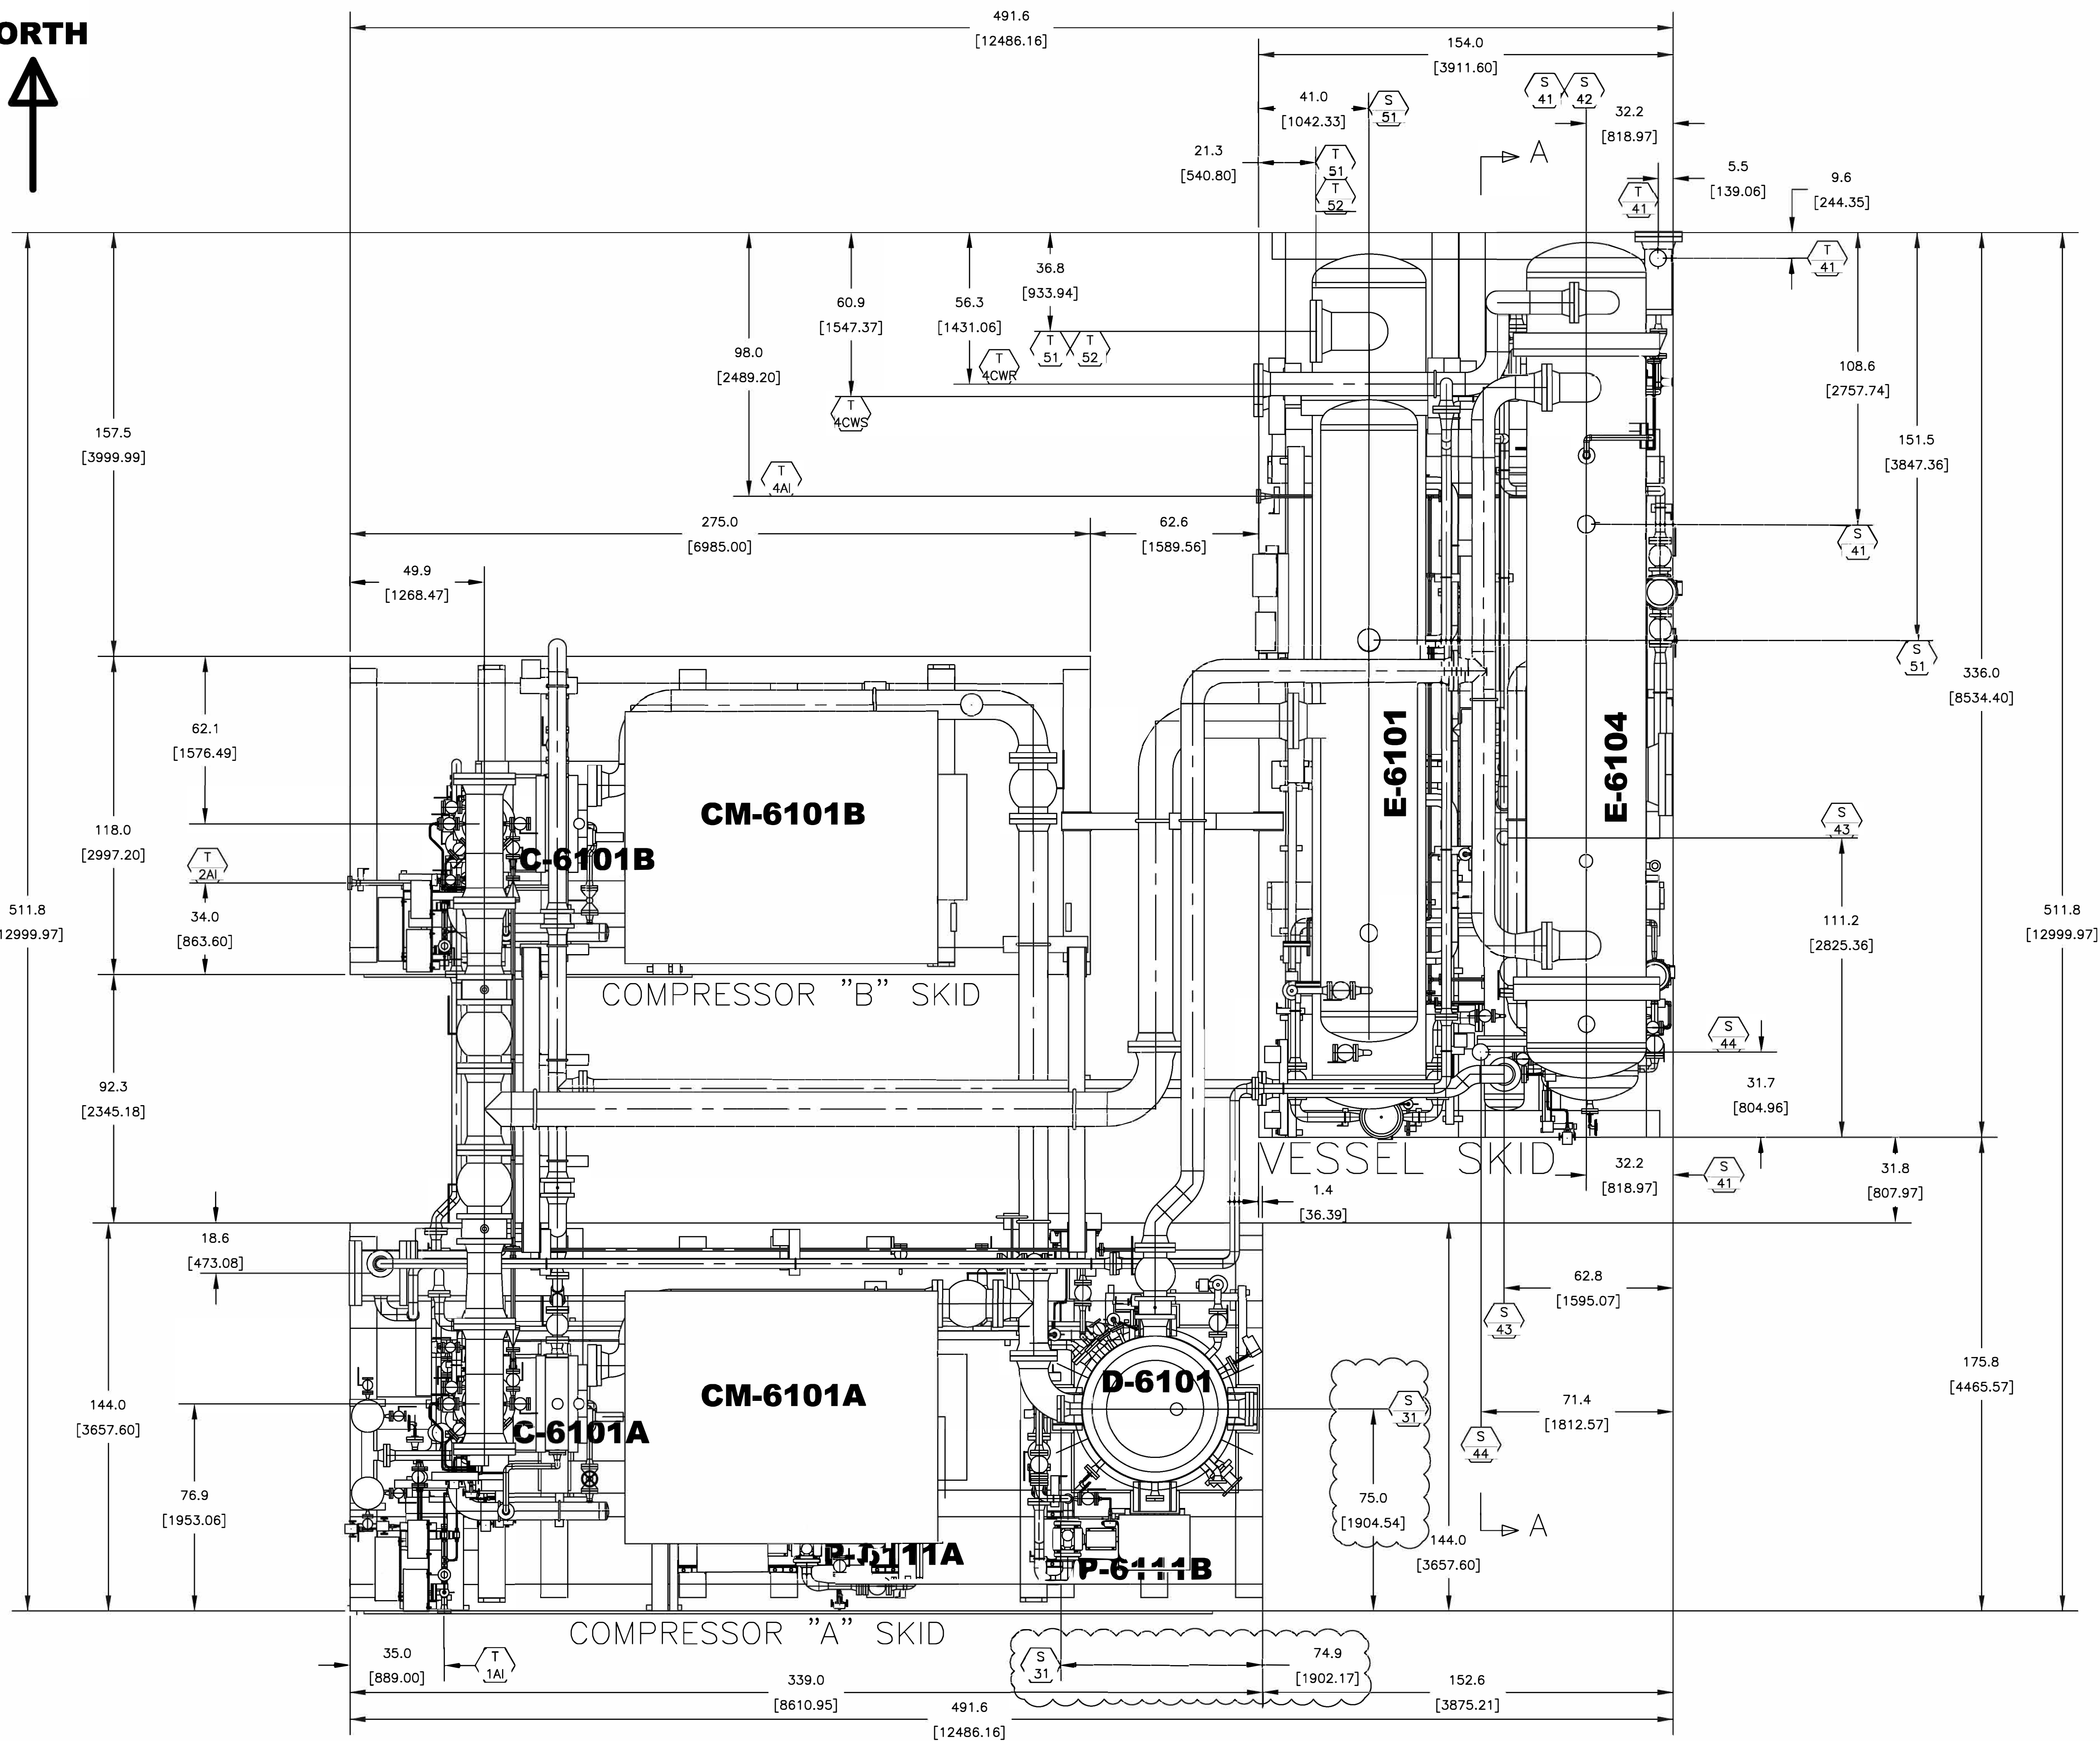

NOTES:

- FOR OPERATING AND DRY WEIGHTS, REFER TO ULT003-50098.
- FOR CENTER OF GRAVITY, REFER TO ULT003-50098.
- FOR DYNAMIC AND STATIC LOADS, REFER TO ULT003-50098.
- FOR FOUNDATION DETAIL DRAWING, REFER TO ULT003-20021.
- FOR LIFTING DETAILS, REFER TO ULT003-20011A.
- FOR SKID INSTALLATION, REFER TO INSTRUCTION AND OPERATIONAL MANUAL ULT003-20092.
- DIMENSIONS ARE IN INCHES AND MM IN PARENTHESIS.
- ANCHOR HOLES TOLERANCES ± 0.13 in (± 3.2 mm).
- BEAM LOCATION TOLERANCES: ± 0.13 in (± 3.2 mm).
- NON-SKID GRATING UNDER MAINTENANCE AREA IS NOT INCLUDED.
- SKID FLATNESS SHALL BE 0.0625" (1.6 mm).
- SURFACE PREPARATION SHALL BE PER PROJECT PAINTING SPECIFICATION.
- ANCHOR BOLT HOLES SHALL BE WITHIN THE SAME XY AND XZ PLANES WITHIN ± 0.13 in (± 3.2 mm).
- COMPRESSOR SKIDS SHALL BE GROUTED. GROUT SPECIFICATION AND SELECTION BY OTHER AND SHALL BE SUITABLE TO PAINTING APPLICATION.
- FOR PIPE NOZZLE LOADS REFER TO DOCUMENT NUMBER VD-GPIC-MA-3029-3029-0062-G (ULT003-20011G)

Code1	<input type="checkbox"/> No Comment/ Approved (Applicable Only for "FOR REVIEW" and "For Approval" Documents) No comment and the document are released for Manufacturing
Code2	<input type="checkbox"/> No Comment / Approved with Note(s) Vendor/Sub-Contractor shall correct, revise and resubmit the document. The document is released for Manufacturing if changes incorporated.
Code3	<input type="checkbox"/> Commented Vendor/Sub-Contractor shall correct, revise and resubmit the document by the date specified. The document shall be raised under the Status of "R: Revised Issue". All corrected documents shall be resubmitted before starting the Manufacturing Process
Code4	<input type="checkbox"/> Not Accepted (Rejected) Vendor/Sub-Contractor shall re-work/re-design/re-specify the contents of the document according to the comments/reasons for rejection. All corrected documents shall be resubmitted before starting the manufacturing. Vendor/Sub-Contractor shall not proceed with subsequent works of Material Supply or Manufacturing until receiving Code1/Code2 or No Code from PURCHASER. Vendor/Sub-Contractor shall resubmit the document with the same revision within 6 working days after receiving comments
No Code	<input type="checkbox"/> No Code (Only for "For Information" Documents and "As Built DWG") Document has been submitted for PURCHASER's Information (I). Considering completeness and correctness of document content is in Vendor/Sub-Contractor's responsibility.

The above checking result by EIED shall in no way relieve Vendor of any liability, obligation and responsibility out of the purchase order and the mutual agreement in writing.

EIED

DATE: _____
DEPT: _____
Signature: _____

CV	PI	EL	IN	ME	MA
ST	BU	PR	SA	HW	TL

04	20.02.2026	IFA	FA	IM	OG
03	13.12.2025	IFA	FA	IM	OG
02	30.09.2025	IFA	FA	IM	OG
01	14.09.2025	IFA	FA	IM	OG
00	15.06.2025	IFA	FA	IM	OG

REV.	DATE (DD.MM.YY)	Purpose of Issue	Prepared	Checked	Approved
------	-----------------	------------------	----------	---------	----------

GPI Sachsan Polymer Industries Company

HOPE Plant

EIED

DELTA PROCESS EQUIPMENT


CONTRACT NO.: GPI-CON-99-008

PO No.: xxxxx


SCALE: 3/8":1'

DRAWING TITLE: **GENERAL ARRANGEMENT DRAWING**

DRAWING NO.	VD-GPIC-MA-3029-3029-0062	REV.	SHEET NO.	SIZE
		04	1 OF 9	A1

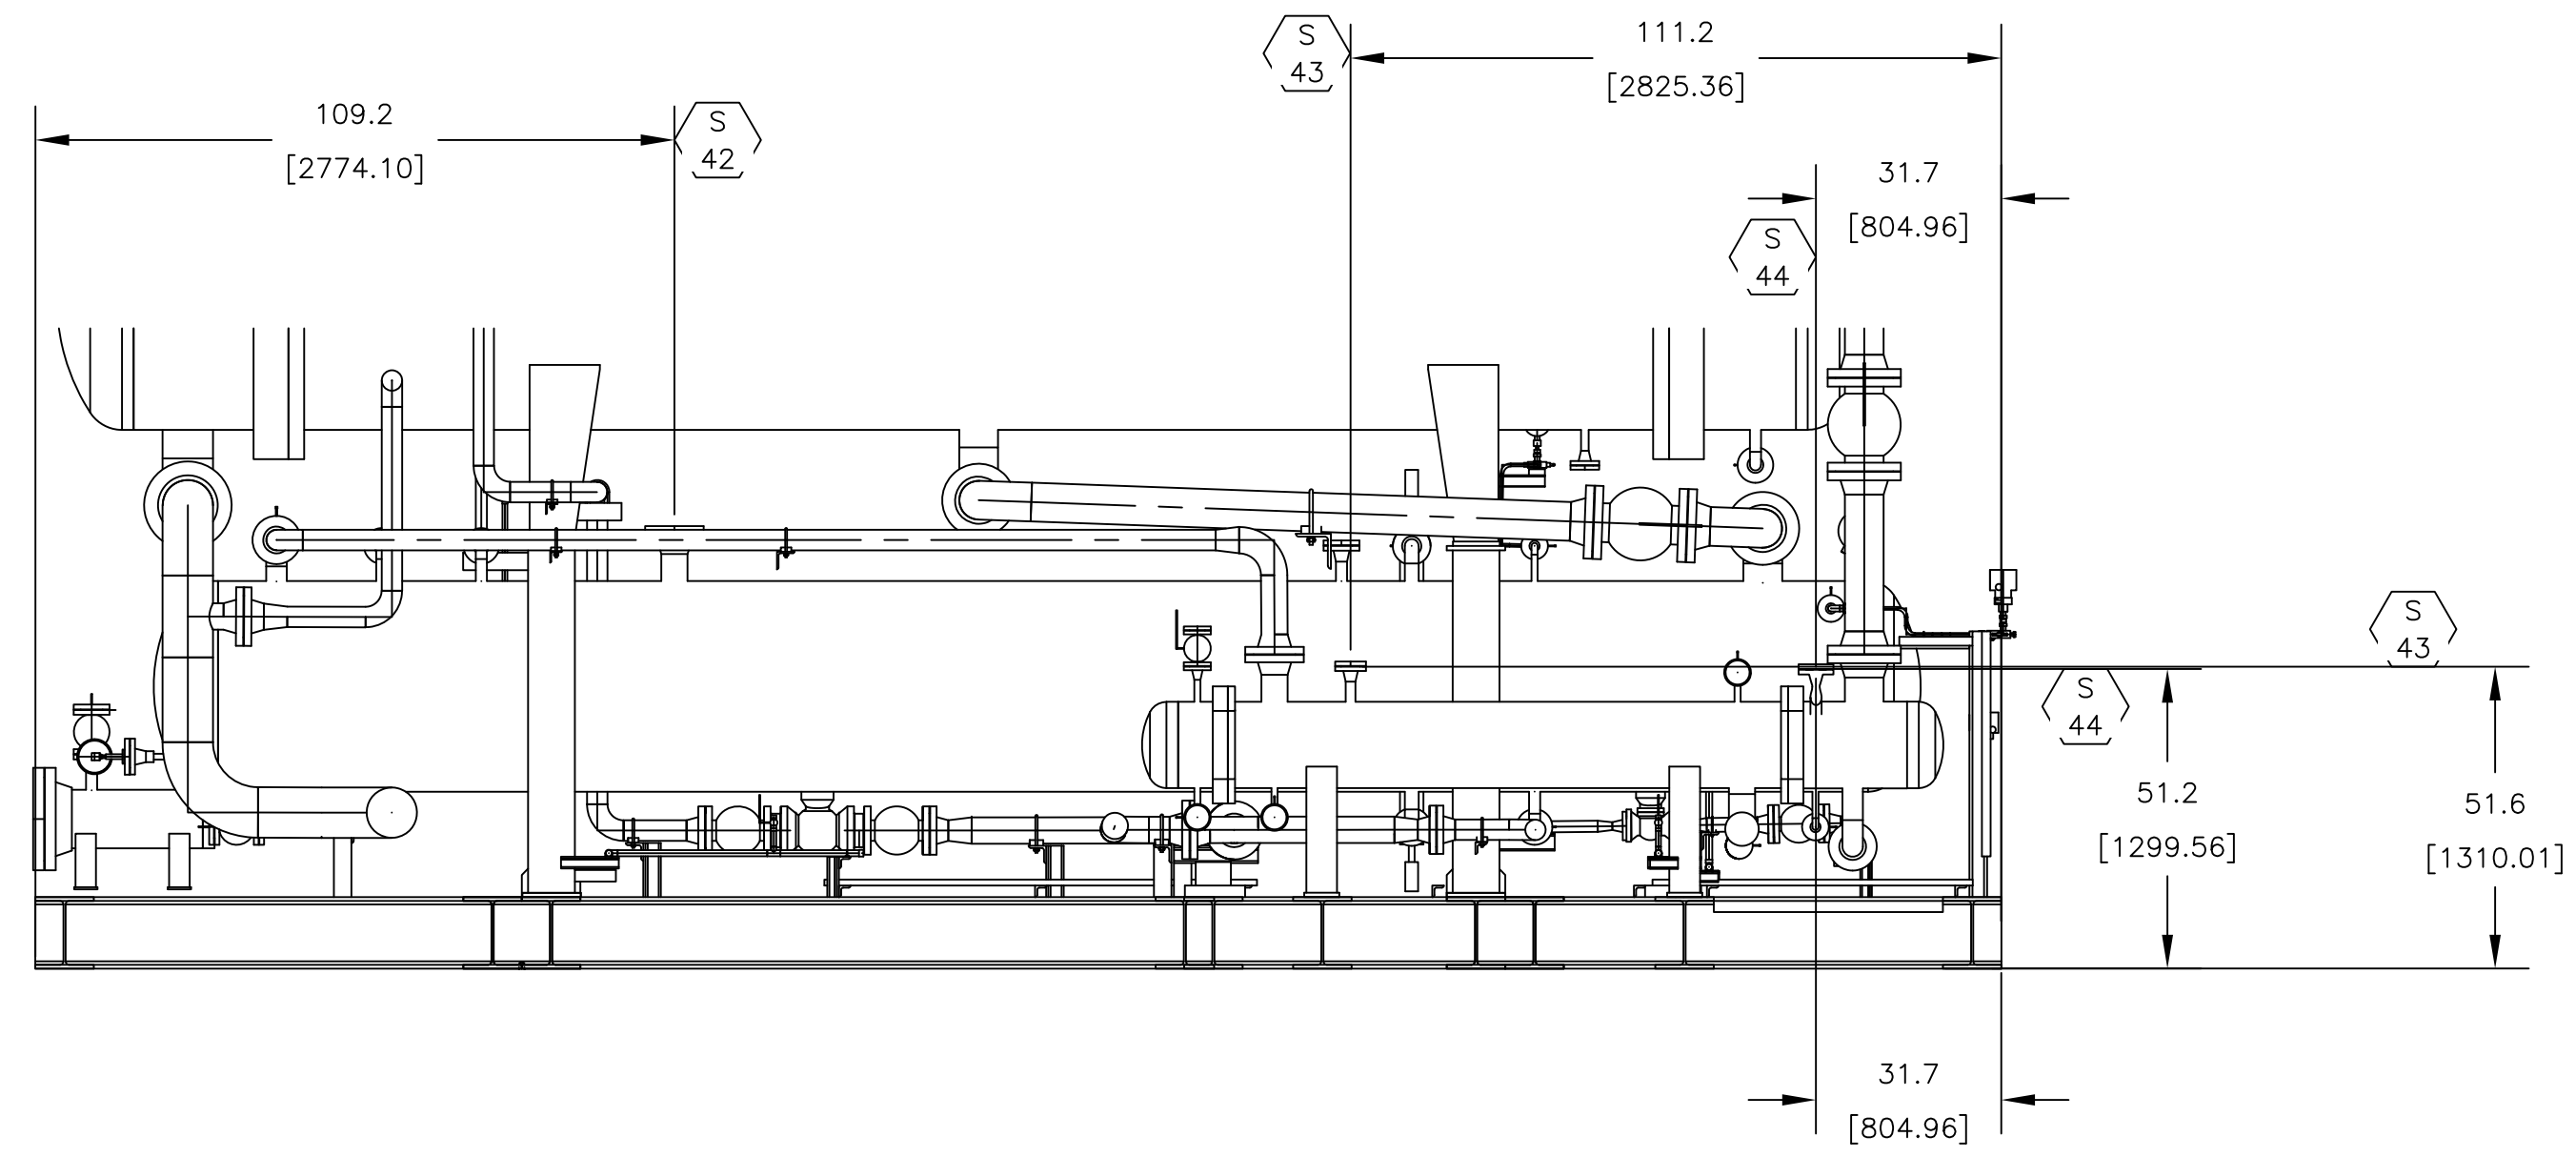

SECTION A - A

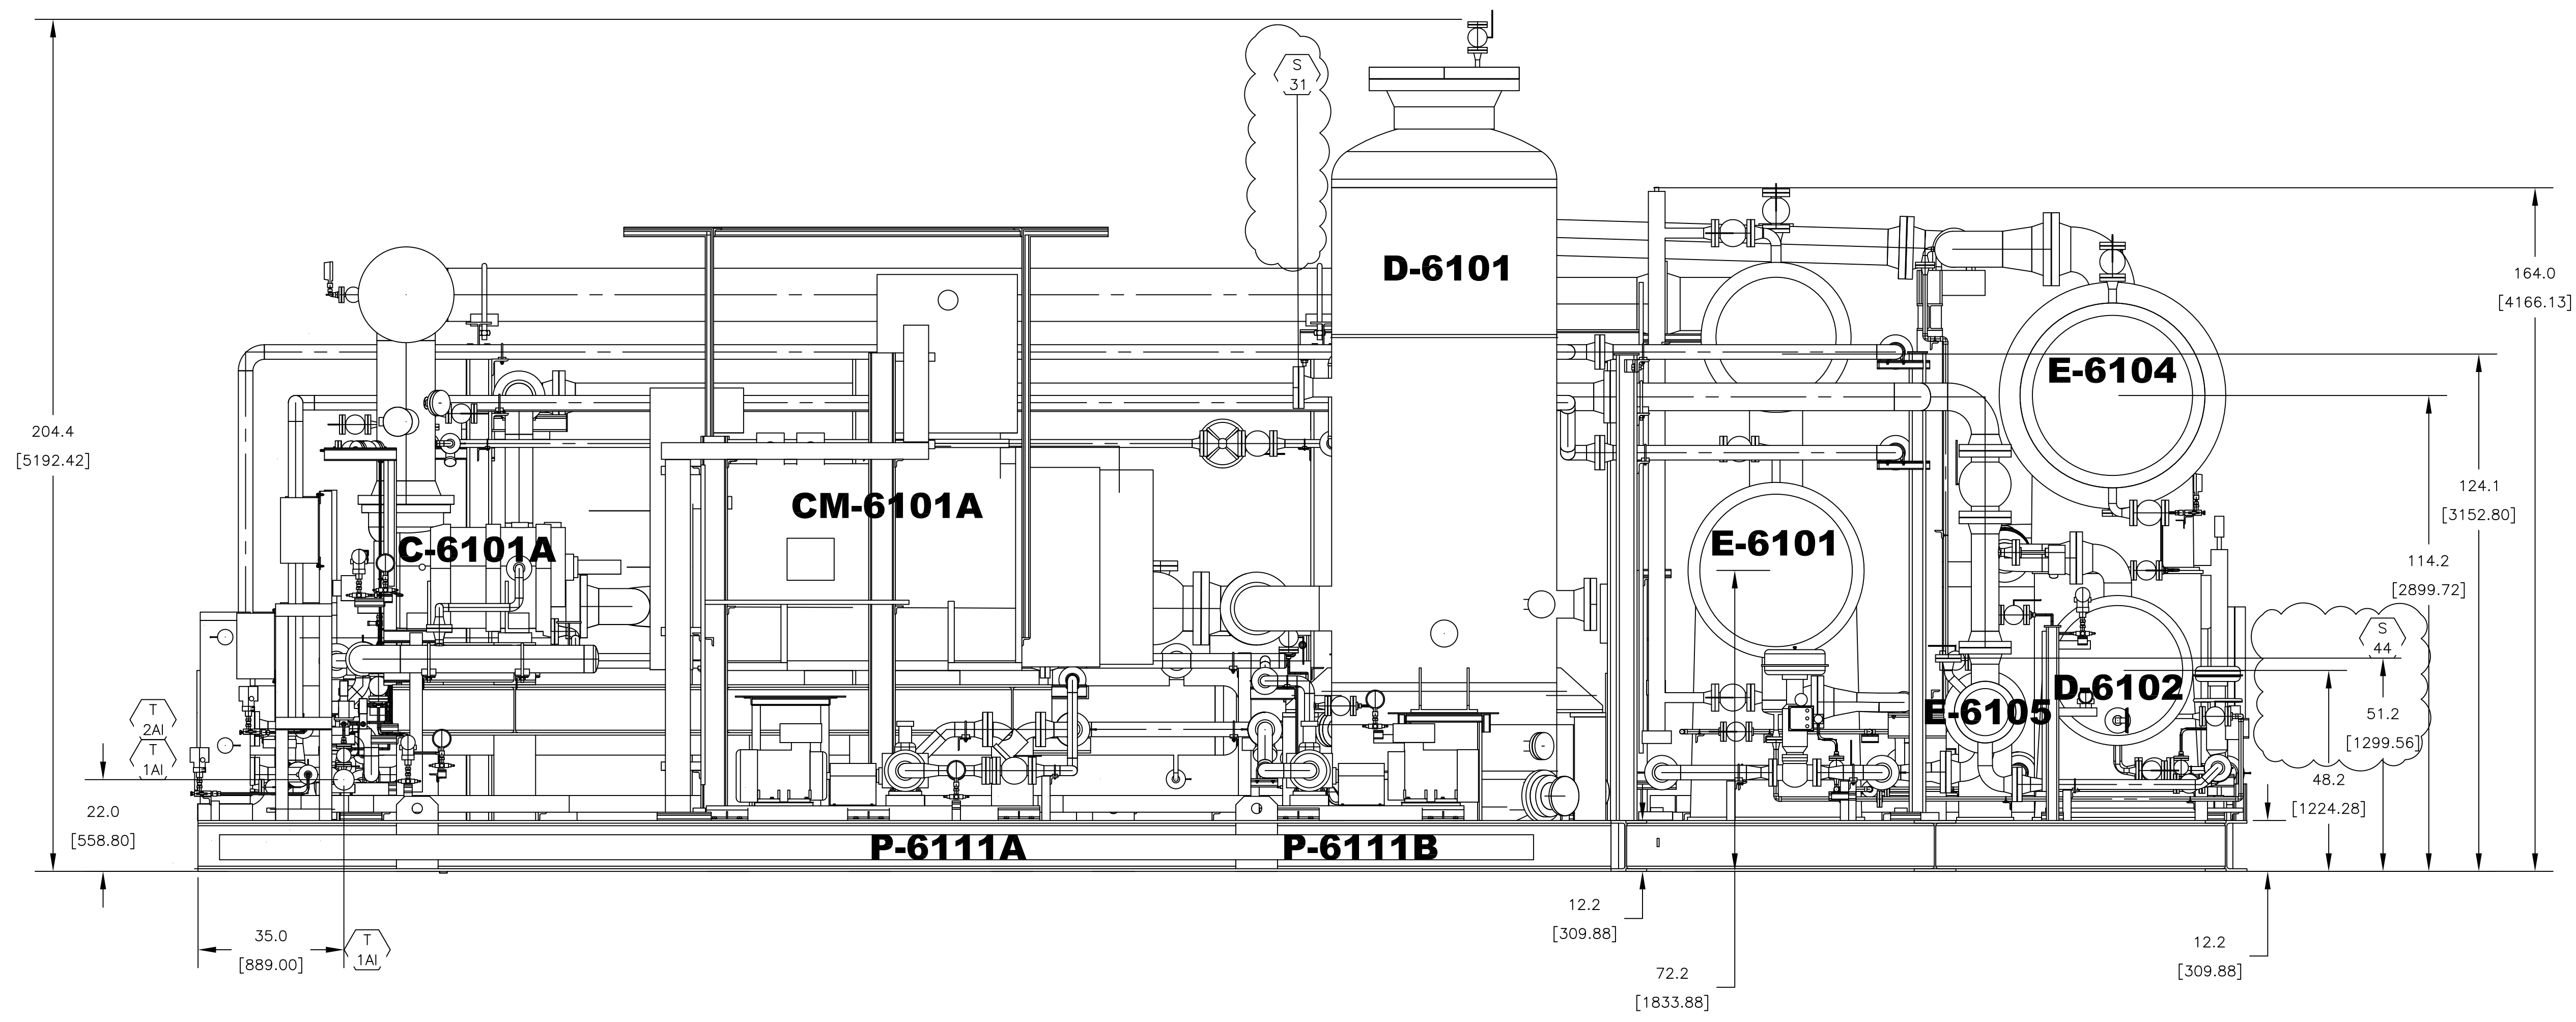

FRONT VIEW

Code1	<input type="checkbox"/> No Comment/ Approved (Applicable Only for "FOR REVIEW" and "For Approval" Documents) No comment and the document are released for Manufacturing				
Code2	<input type="checkbox"/> No Comment / Approved with Note(s) Vendor/Sub-Contractor shall correct, revise and resubmit the document. The document is released for Manufacturing if changes incorporated.				
Code3	<input type="checkbox"/> Commented Vendor/Sub-Contractor shall correct, revise and resubmit the document by the date specified. The document shall be revised under the Status of "R: Revised Issue". All corrected documents shall be resubmitted before starting the Manufacturing Process				
Code4	<input type="checkbox"/> Not Accepted (Rejected) Vendor/Sub-Contractor shall re-work/re-design/re-specify the contents of the document according to the comments/reasons for rejection. All corrected documents shall be resubmitted before starting the manufacturing. Vendor/Sub-Contractor shall not proceed with subsequent works of Material Supply or Manufacturing until receiving Code1/Code2 or No Code from PURCHASER. Vendor/Sub-Contractor shall resubmit the document with the same revision within 6 working days after receiving comments				
No Code	<input type="checkbox"/> No Code (Only for "For Information" Documents and "As Built DWGs") Document has been submitted for PURCHASER'S information (If) Consistency, completeness and correctness of document content is in Vendor/Sub-Contractor's responsibility.				
The above checking result by EIED shall in no way relieve Vendor of any liability, obligation and responsibility out of the purchase order and the mutual agreement in writing					
DATE : DEPT : Signature :					
CV	PI	EL	IN	ME	MA
ST	BU	PR	SA	HV	TL

04	20.02.2026	IFA	FA	IM	OG
03	13.12.2025	IFA	FA	IM	OG
02	30.09.2025	IFA	FA	IM	OG
01	14.09.2025	IFA	FA	IM	OG
00	15.06.2025	IFA	FA	IM	OG
REV.	DATE (dd.MM.YY)	Purpose of Issue	Prepared	Checked	Approved

Gachasan Plymer Industries Company
HDPE Plant

CONTRACT NO.: GPI-CON-99-008

PO No.: xxxxxx


SCALE: 1/2":1'

DRAWING TITLE: **GENERAL ARRANGEMENT DRAWING**

DRAWING NO.	REV.	SHEET NO.	SIZE
VD-GPIC-MA-3029-3029-0062	04	2 OF 9	A1

CONNECTION LIST			
NO.	LOCATION	DESCRIPTION	SIZE
T-1AI	COMPRESSOR SKID-A	INSTRUMENT AIR SUPPLY	1"-300 ANSI RF
T-2AI	COMPRESSOR SKID-B	INSTRUMENT AIR SUPPLY	1"-300 ANSI RF
T-4AI	VESSEL SKID	INSTRUMENT AIR SUPPLY	1"-300 ANSI RF
T-4CWS	VESSEL SKID	OIL COOLER COOLING WATER SUPPLY	8"-300 ANSI RF
T-4CWR	VESSEL SKID	OIL COOLER COOLING WATER RETURN	8"-300 ANSI RF
T-41	VESSEL SKID	FILTER/DRYER INLET	1-1/2"-300 ANSI RF
T-51	VESSEL SKID	CHILLER PROCESS INLET	14"-300 ANSI RF
T-52	VESSEL SKID	CHILLER PROCESS OUTLET	14"-300 ANSI RF
S-31	COMPRESSOR SKID-A	OIL SEPARATOR PRESSURE SAFETY	4"-300 ANSI RF
S-41	VESSEL SKID	CONDENSER PRESSURE SAFETY	3"-300 ANSI RF
S-42	VESSEL SKID	RECEIVER PRESSURE SAFETY	4"-300 ANSI RF
S-43	VESSEL SKID	ECONOMIZER PRESSURE SAFETY-SHELL	1-1/2"-300 ANSI RF
S-44	VESSEL SKID	ECONOMIZER PRESSURE SAFETY-TUBE	1-1/2"-300 ANSI RF
S-51	VESSEL SKID	CHILLER PRESSURE SAFETY	3"-300 ANSI RF

EQUIPMENT TAG NUMBER	
TAG NO.	DESCRIPTION
C-6101A	COMPRESSOR
C-6101B	COMPRESSOR
CM-6101A	COMPRESSOR MOTOR
CM-6101B	COMPRESSOR MOTOR
E-6101	CHILLER
E-6102	OIL COOLER
E-6104	CONDENSER
E-6105	ECONOMIZER
D-6101	OIL SEPARATOR
D-6102	RECEIVER
P-6111A/A	OIL PUMPS
PM-6111A/A	OIL PUMP MOTORS
F-6102	FILTER/DRYER
F-6101A/B	OIL FILTER

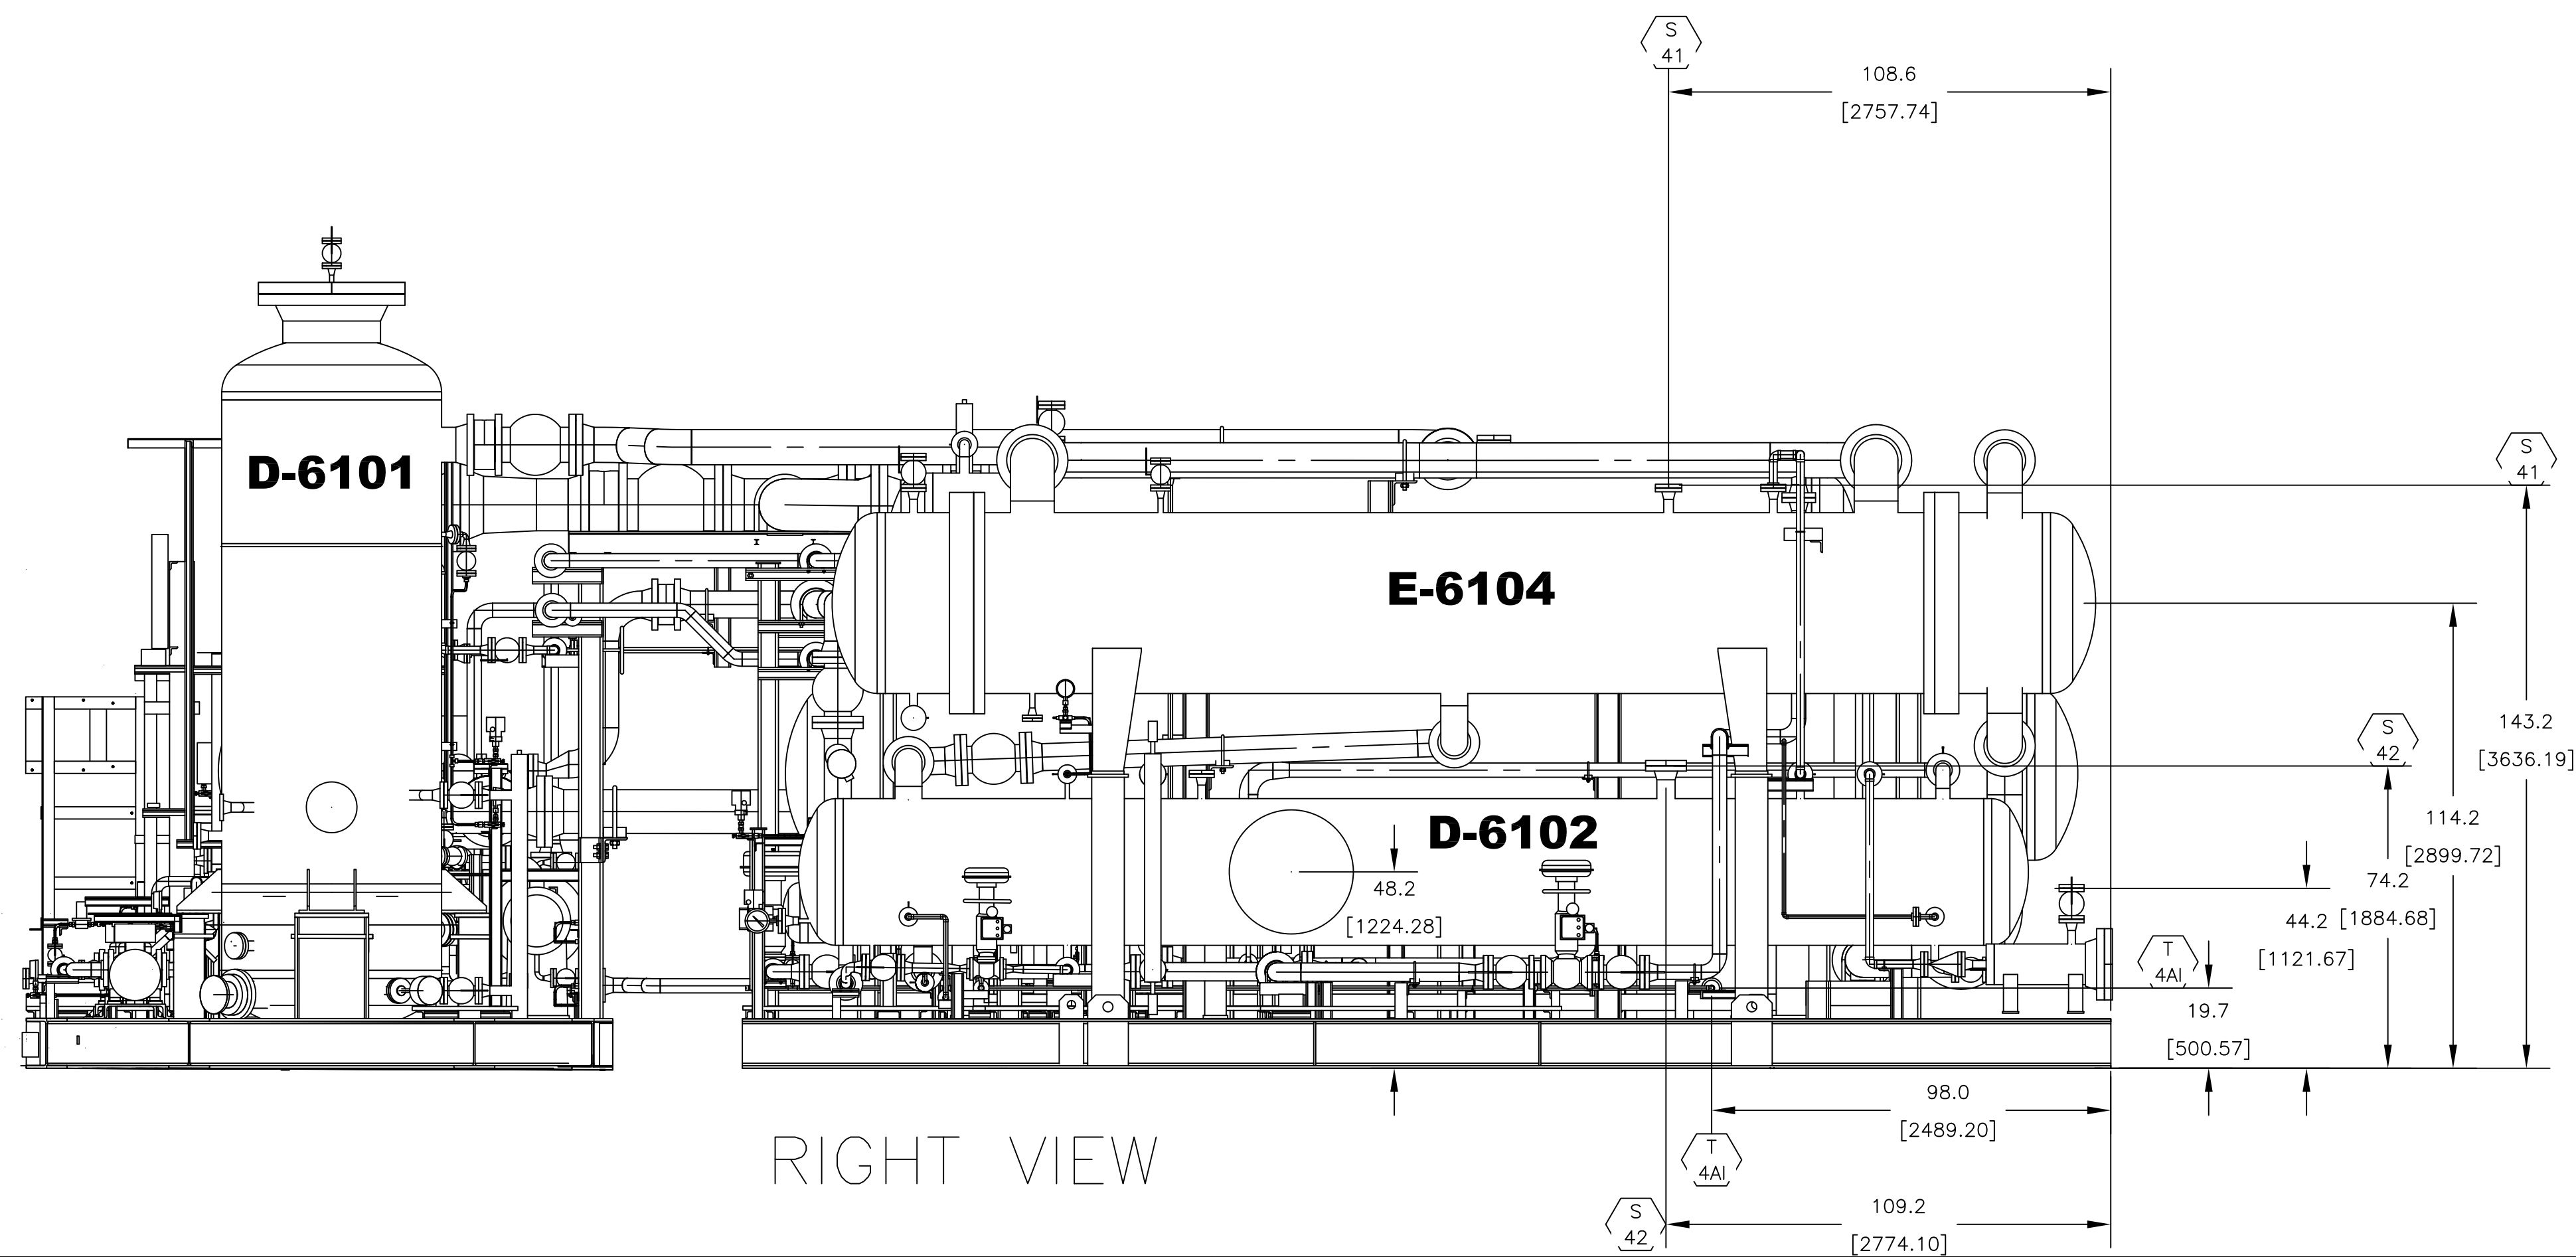

Code1	<input type="checkbox"/> No Comment/ Approved (Applicable Only for "FOR REVIEW" and "For Approval" Documents) No comment and the document are released for Manufacturing				
Code2	<input type="checkbox"/> No Comment / Approved with Note(s) Vendor/Sub-Contractor shall correct, revise and resubmit the document. The document is released for Manufacturing if changes incorporated.				
Code3	<input type="checkbox"/> Commented Vendor/Sub-Contractor shall correct, revise and resubmit the document by the date specified. The document shall be revised under the Status of "R: Revised Issue". All corrected documents shall be resubmitted before starting the Manufacturing Process				
Code4	<input type="checkbox"/> Not Accepted (Rejected) Vendor/Sub-Contractor shall re-work/re-design/re-specify the contents of the document according to the comments/reasons for rejection. All corrected documents shall be resubmitted before starting the manufacturing. Vendor/Sub-Contractor shall not proceed with subsequent works of Material Supply or Manufacturing unit receiving Code1/Code2 or No Code from PURCHASER. Vendor/Sub-Contractor shall resubmit the document with the same revision within 6 working days after receiving comments				
No Code	<input type="checkbox"/> No Code (Only for "For Information" Documents and "As Built DWGs") Document has been submitted for PURCHASER's information (If). Considering completeness and correctness of document content is in Vendor/Sub-Contractor's responsibility.				
The above checking result by EIED shall in no way relieve Vendor of any liability, obligation and responsibility out of the purchase order and the mutual agreement in writing.					
DATE : DEPT : Signature :					
CV	PI	EL	IN	ME	MA
ST	BU	PR	SA	HY	TL

04	20.02.2026	IFA	FA	IM	OG
03	13.12.2025	IFA	FA	IM	OG
02	30.09.2025	IFA	FA	IM	OG
01	14.09.2025	IFA	FA	IM	OG
00	15.06.2025	IFA	FA	IM	OG
REV.	DATE (dd.MM.YY)	Purpose of Issue	Prepared	Checked	Approved

GPI Gachsaran Polymer Industries Company

Gachsaran Polymer Industries Company
HDPE Plant

CONTRACT NO.: GPI-CON-99-008


PO No.: xxxxxx

DRAWING TITLE: **GENERAL ARRANGEMENT DRAWING**

DRAWING NO. VD-GPIC-MA-3029-3029-0062

REV.	SHEET NO.	SIZE
04	3 OF 9	A1

SCALE: 1/2":1'

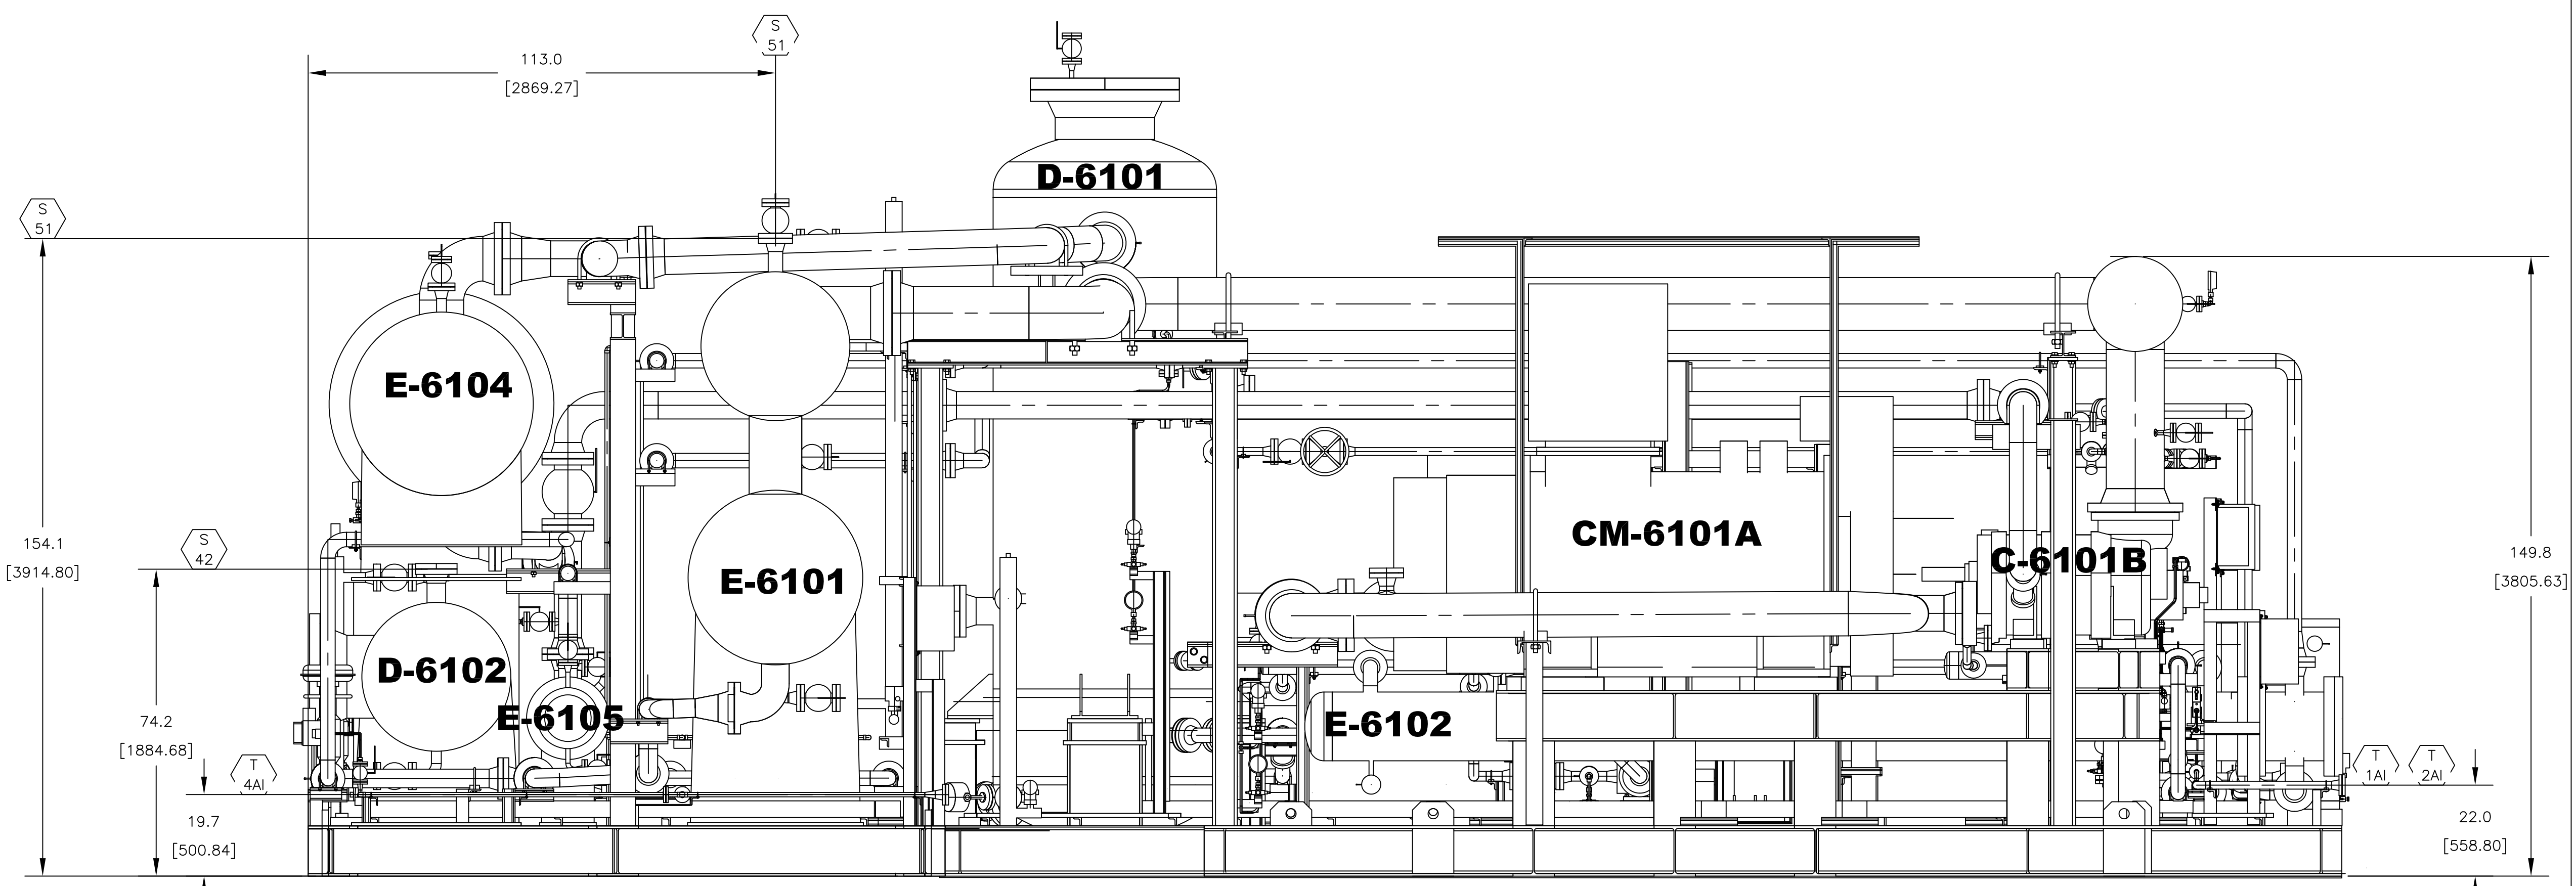

BACK VIEW


Code1	<input type="checkbox"/> No Comment/ Approved (Applicable Only for "FOR REVIEW" and "For Approval" Documents) No comment and the document are released for Manufacturing.				
Code2	<input type="checkbox"/> No Comment / Approved with Note(s) Vendor/Sub-Contractor shall correct, revise and resubmit the document. The document is released for Manufacturing if changes incorporated.				
Code3	<input type="checkbox"/> Commented Vendor/Sub-Contractor shall correct, revise and resubmit the document by the date specified. The document shall be revised under the Status of "R: Revised Issue". All corrected documents shall be resubmitted before starting the Manufacturing Process.				
Code4	<input type="checkbox"/> Not Accepted (Rejected) Vendor/Sub-Contractor shall re-work/re-design/re-specify the contents of the document according to the comments/reasons for rejection. All corrected documents shall be resubmitted before starting the manufacturing. Vendor/Sub-Contractor shall not proceed with subsequent works of Material Supply or Manufacturing unit receiving Code1/Code2 or No Code from PURCHASER. Vendor/Sub-Contractor shall resubmit the document with the same revision within 6 working days after receiving comments.				
No Code	<input type="checkbox"/> No Code (Only for "For Information" Documents and "As Built DWGs") Document has been submitted for PURCHASER'S information (I). Considering completeness and correctness of document content is in Vendor/Sub-Contractor's responsibility.				
The above checking result by EIED shall in no way relieve Vendor of any liability, obligation and responsibility out of the purchase order and the mutual agreement in writing.					
DATE : _____ DEPT: _____ Signature : _____					
CV	PI	EL	IN	ME	MA
ST	BU	PR	SA	HV	TL

04	20.02.2026	IFA	FA	IM	OG
03	13.12.2025	IFA	FA	IM	OG
02	30.09.2025	IFA	FA	IM	OG
01	14.09.2025	IFA	FA	IM	OG
00	15.06.2025	IFA	FA	IM	OG
REV.	DATE (dd.MM.YY)	Purpose of Issue	Prepared	Checked	Approved


		Gachasan Plymter Industries Company HDPE Plant	
		CONTRACT NO.: GPI-CON-99-008	
PO No.: xxxxx		SCALE: 1/2":1'	

DRAWING TITLE: **GENERAL ARRANGEMENT DRAWING**



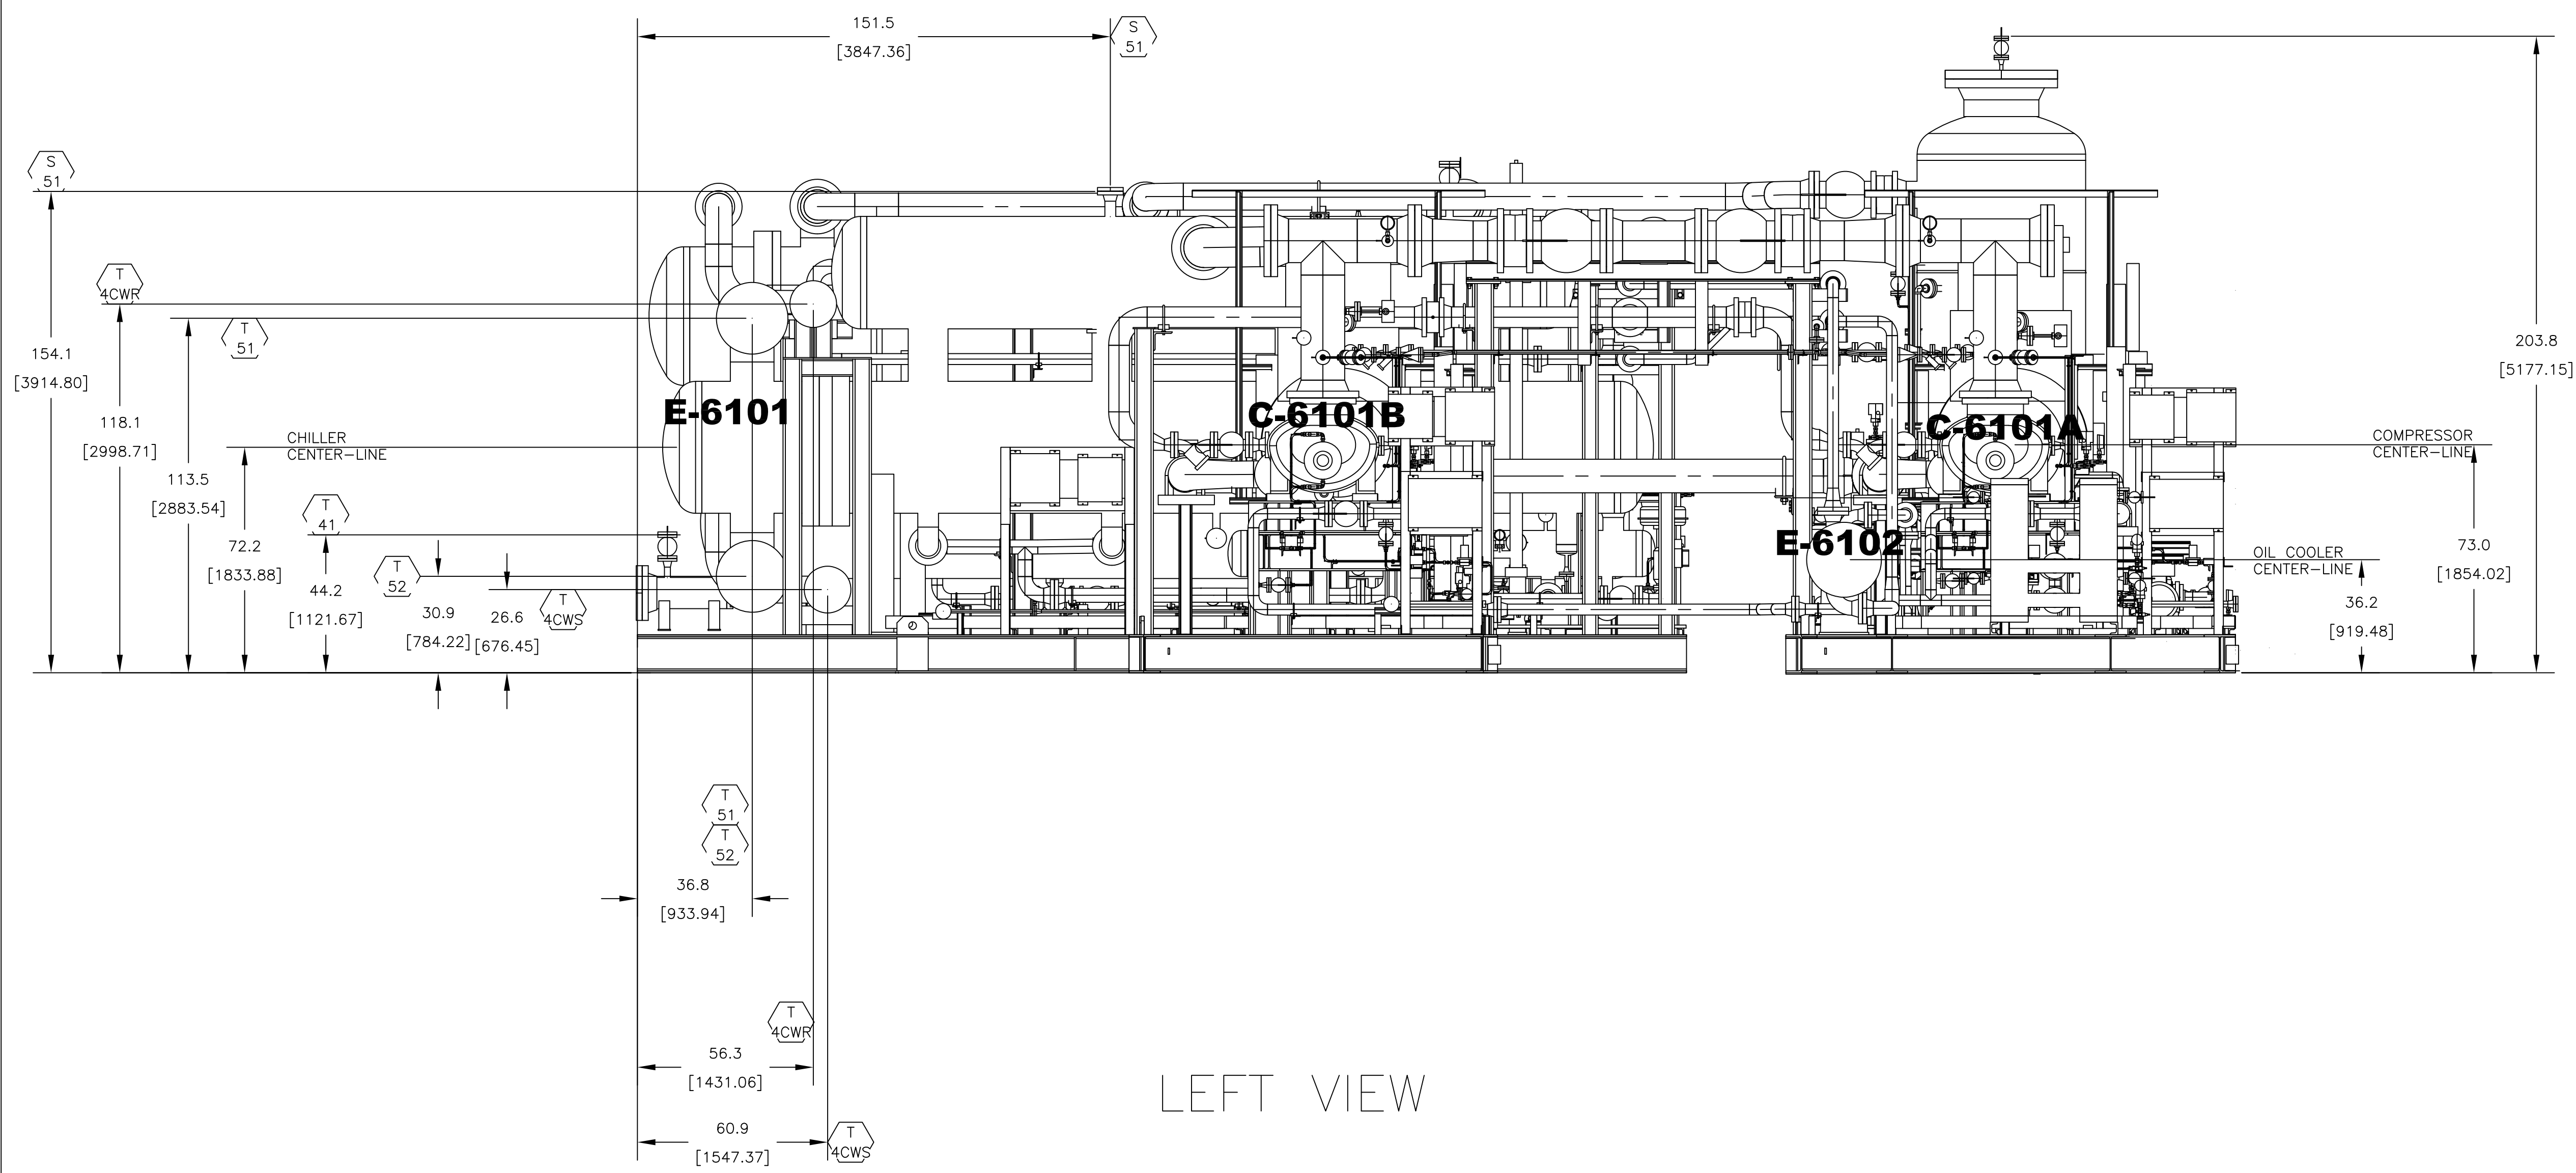

DRAWING NO.	REV.	SHEET NO.	SIZE
VD-GPIC-MA-3029-3029-0062	04	4 OF 9	A1




LEFT VIEW


Code1	<input type="checkbox"/> No Comment/ Approved (Applicable Only for "FOR REVIEW" and "For Approval" Documents) No comment and the document are released for Manufacturing				
Code2	<input type="checkbox"/> No Comment / Approved with Note(s) Vendor/Sub-Contractor shall correct, revise and resubmit the document. The document is released for Manufacturing if changes incorporated.				
Code3	<input type="checkbox"/> Commented Vendor/Sub-Contractor shall correct, revise and resubmit the document by the date specified. The document shall be revised under the Status of "R: Revised Issue". All corrected documents shall be resubmitted before starting the Manufacturing Process				
Code4	<input type="checkbox"/> Not Accepted (Rejected) Vendor/Sub-Contractor shall re-work/re-design/re-specify the contents of the document according to the comments/reasons for rejection. All corrected documents shall be resubmitted before starting the manufacturing. Vendor/Sub-Contractor shall not proceed with subsequent works of Material Supply or Manufacturing unit receiving Code1/Code2 or No Code from PURCHASER. Vendor/Sub-Contractor shall resubmit the document with the same revision within 6 working days after receiving comments				
No Code	<input type="checkbox"/> No Code (Only for "For Information" Documents and "As Built DWG") Document has been submitted for PURCHASER'S information (If) Considering completeness and correctness of document content is in Vendor/Sub-Contractor's responsibility.				
The above checking result by EIED shall in no way relieve Vendor of any liability, obligation and responsibility out of the purchase order and the mutual agreement in writing					
 DATE : _____ DEPT: _____ Signature : _____					
CV	PI	EL	IN	ME	MA
ST	BU	PR	SA	HY	TL

04	20.02.2026	IFA	FA	IM	OG
03	13.12.2025	IFA	FA	IM	OG
02	30.09.2025	IFA	FA	IM	OG
01	14.09.2025	IFA	FA	IM	OG
00	15.06.2025	IFA	FA	IM	OG
REV.	DATE (dd.MM.YY)	Purpose of Issue	Prepared	Checked	Approved




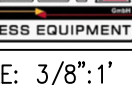
		Gachasan Plyomer Industries Company HDPE Plant	
		CONTRACT NO.: GPI-CON-99-008	
PO No.: xxxxx		SCALE: 3/8":1'	

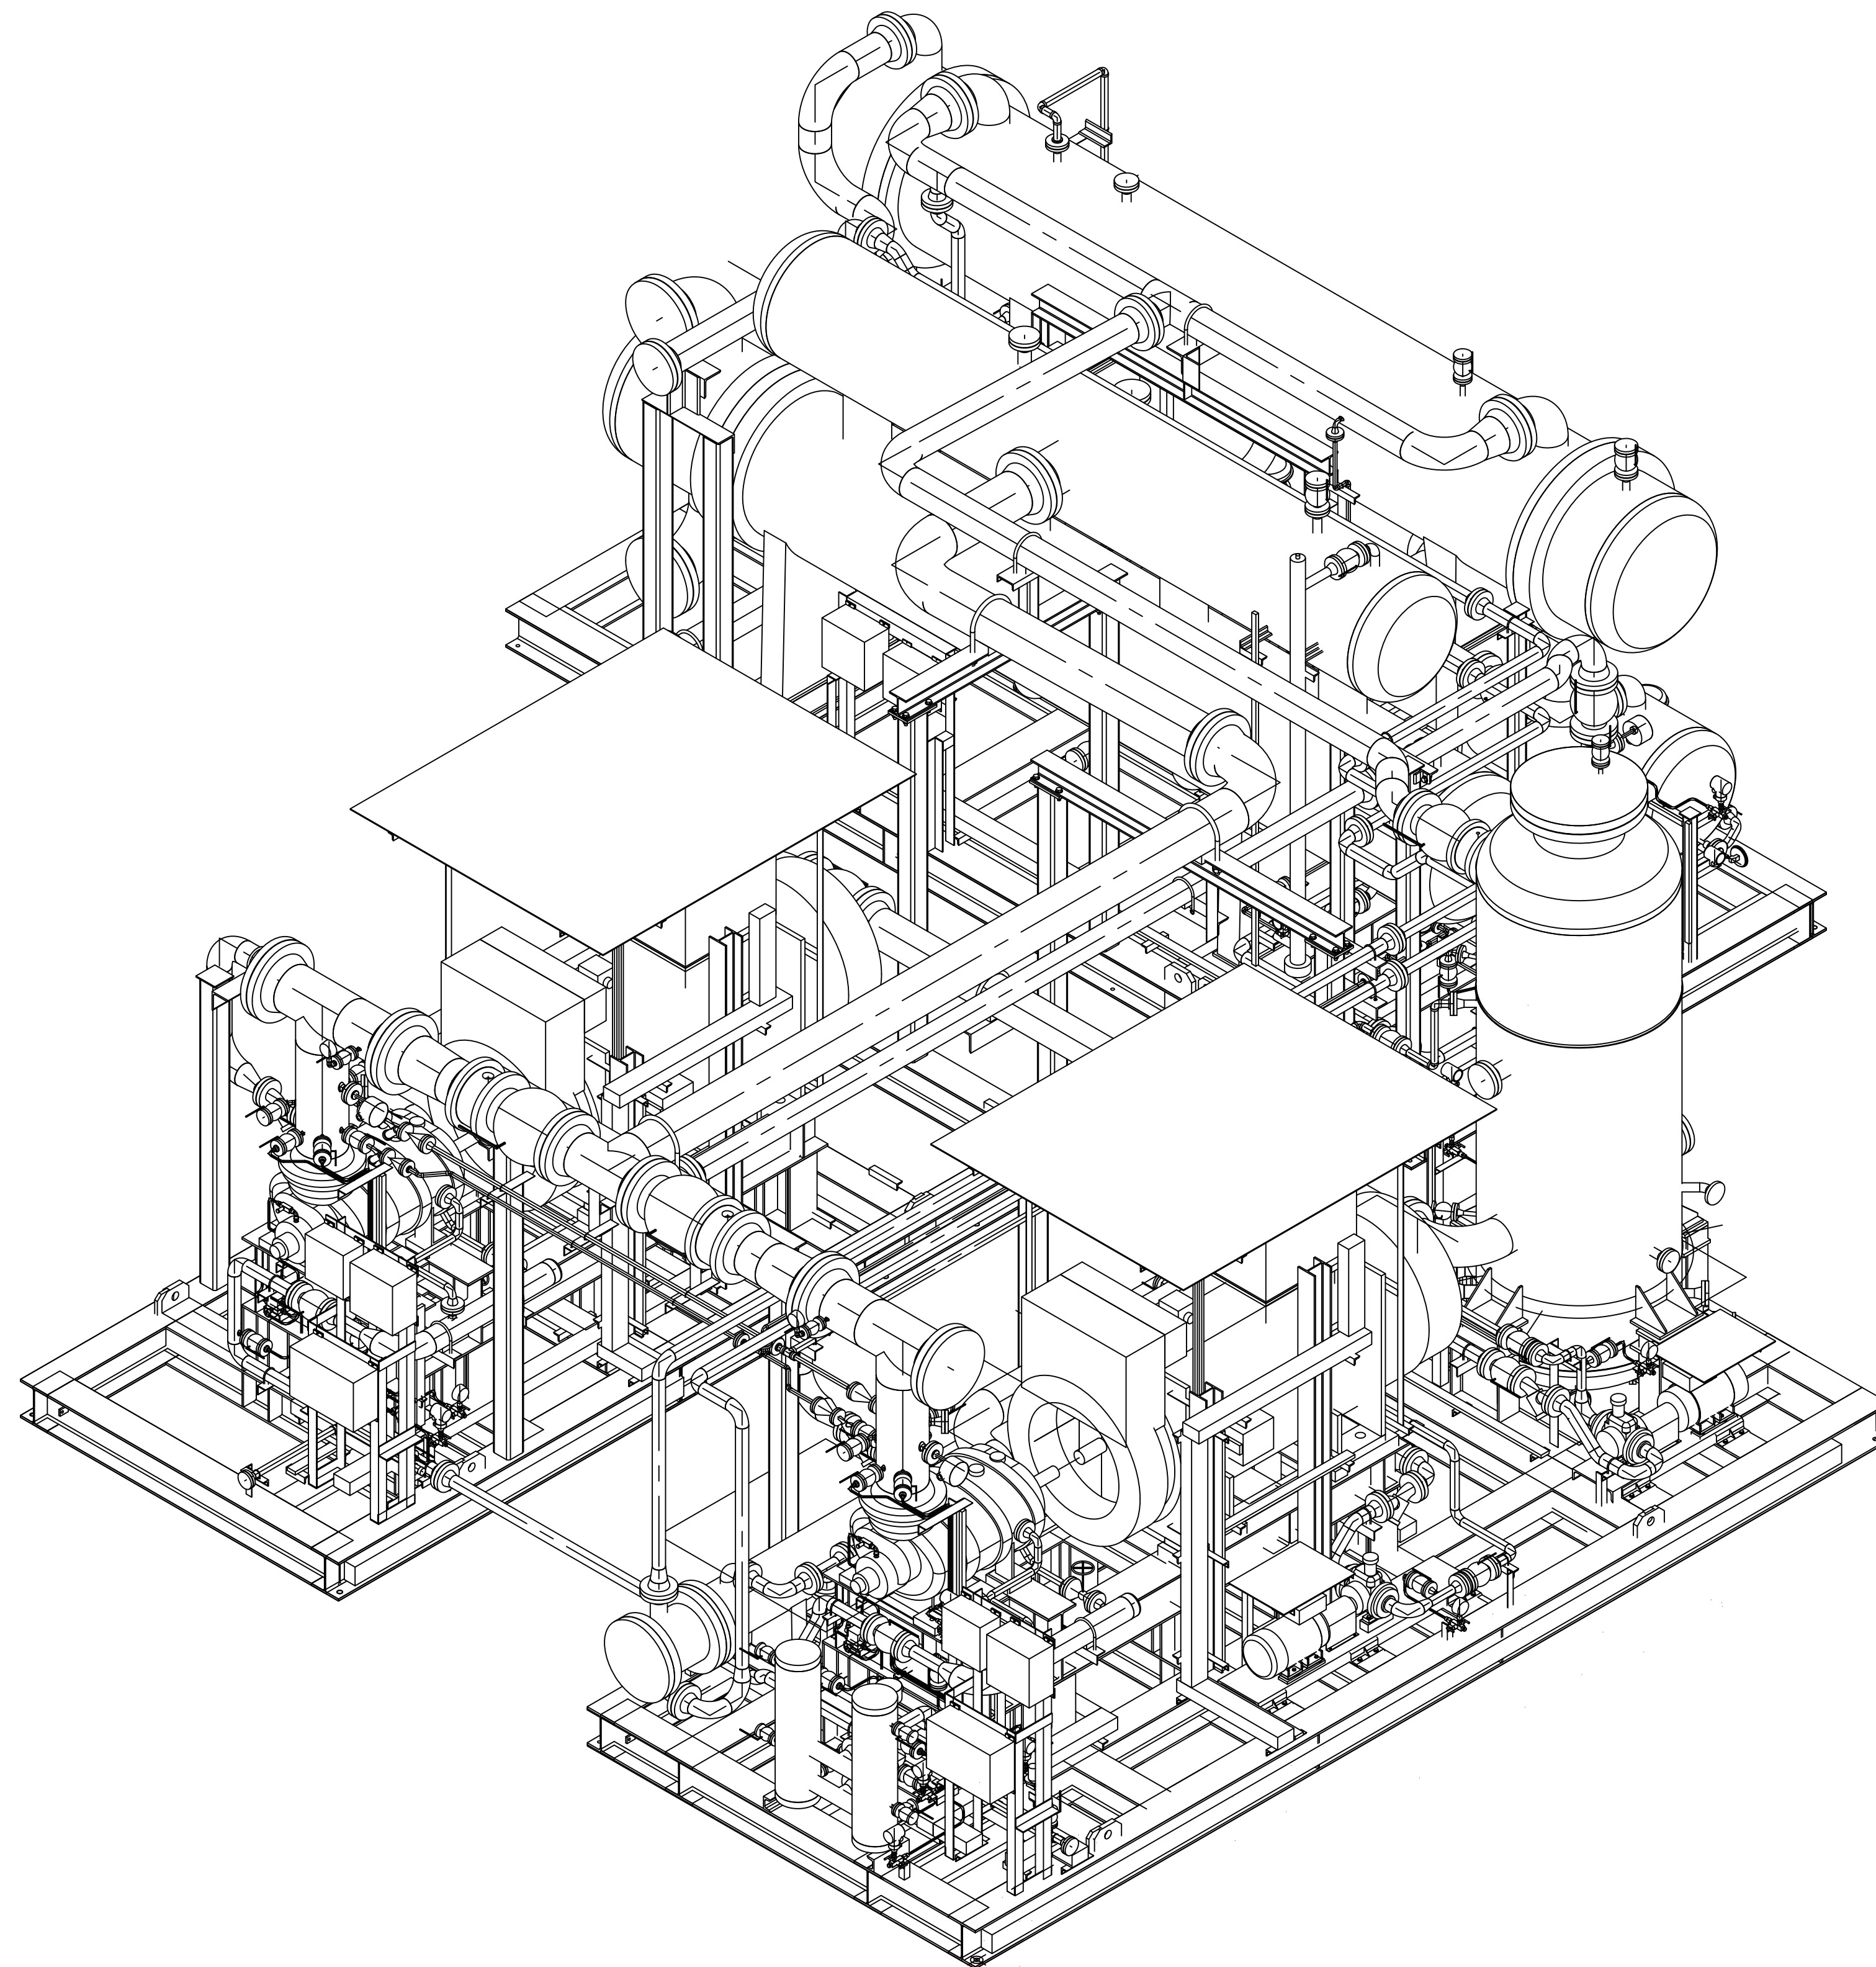DRAWING TITLE: GENERAL ARRANGEMENT DRAWING			
DRAWING NO. VD-GPIC-MA-3029-3029-0062	REV. 04	SHEET NO. 5 OF 9	SIZE A1




Code1	<input type="checkbox"/> No Comment/ Approved (Applicable Only for "FOR REVIEW" and "For Approval" Documents) No comment and the document are released for Manufacturing				
Code2	<input type="checkbox"/> No Comment / Approved with Note(s) Vendor/Sub-Contractor shall correct, revise and resubmit the document. The document is released for Manufacturing if changes incorporated.				
Code3	<input type="checkbox"/> Commented Vendor/Sub-Contractor shall correct, revise and resubmit the document by the date specified. The document shall be revised under the Status of "R: Revised Issue". All corrected documents shall be resubmitted before starting the Manufacturing Process				
Code4	<input type="checkbox"/> Not Accepted (Rejected) Vendor/Sub-Contractor shall re-work/re-design/re-specify the contents of the document according to the comments/reasons for rejection. All corrected documents shall be resubmitted before starting the manufacturing. Vendor/Sub-Contractor shall not proceed with subsequent works of Material Supply or Manufacturing until receiving Code1/Code2 or No Code from PURCHASER. Vendor/Sub-Contractor shall resubmit the document with the same revision within 6 working days after receiving comments				
No Code	<input type="checkbox"/> No Code (Only for "For Information" Documents and "As Built DWGs") Document has been submitted for PURCHASER'S information (It) Consistency, completeness and correctness of document content is in Vendor/Sub-Contractor's responsibility. The above checking result by EIED shall in no way relieve Vendor of any liability, obligation and responsibility out of the purchase order and the mutual agreement in writing				
 DATE : _____ DEPT: _____ Signature : _____					
CV	PI	EL	IN	ME	MA
ST	BU	PR	SA	HV	TL

04	20.02.2026	IFA	FA	IM	OG
03	13.12.2025	IFA	FA	IM	OG
02	30.09.2025	IFA	FA	IM	OG
01	14.09.2025	IFA	FA	IM	OG
00	15.06.2025	IFA	FA	IM	OG
REV.	DATE (dd.MMM.YY)	Purpose of Issue	Prepared	Checked	Approved

 Gachsaran Polymer Industries Company	 Gachsaran Polymer Industries Company HDPE Plant	  DELTA PROCESS EQUIPMENT
CONTRACT NO.: GPI-CON-99-008		SCALE: 3/8":1'

PO No.: xxxxxx					
DRAWING TITLE: GENERAL ARRANGEMENT DRAWING					
DRAWING NO.	REV.	SHEET NO.	SIZE		
VD-GPIC-MA-3029-3029-0062	04	6 OF 9	A1		

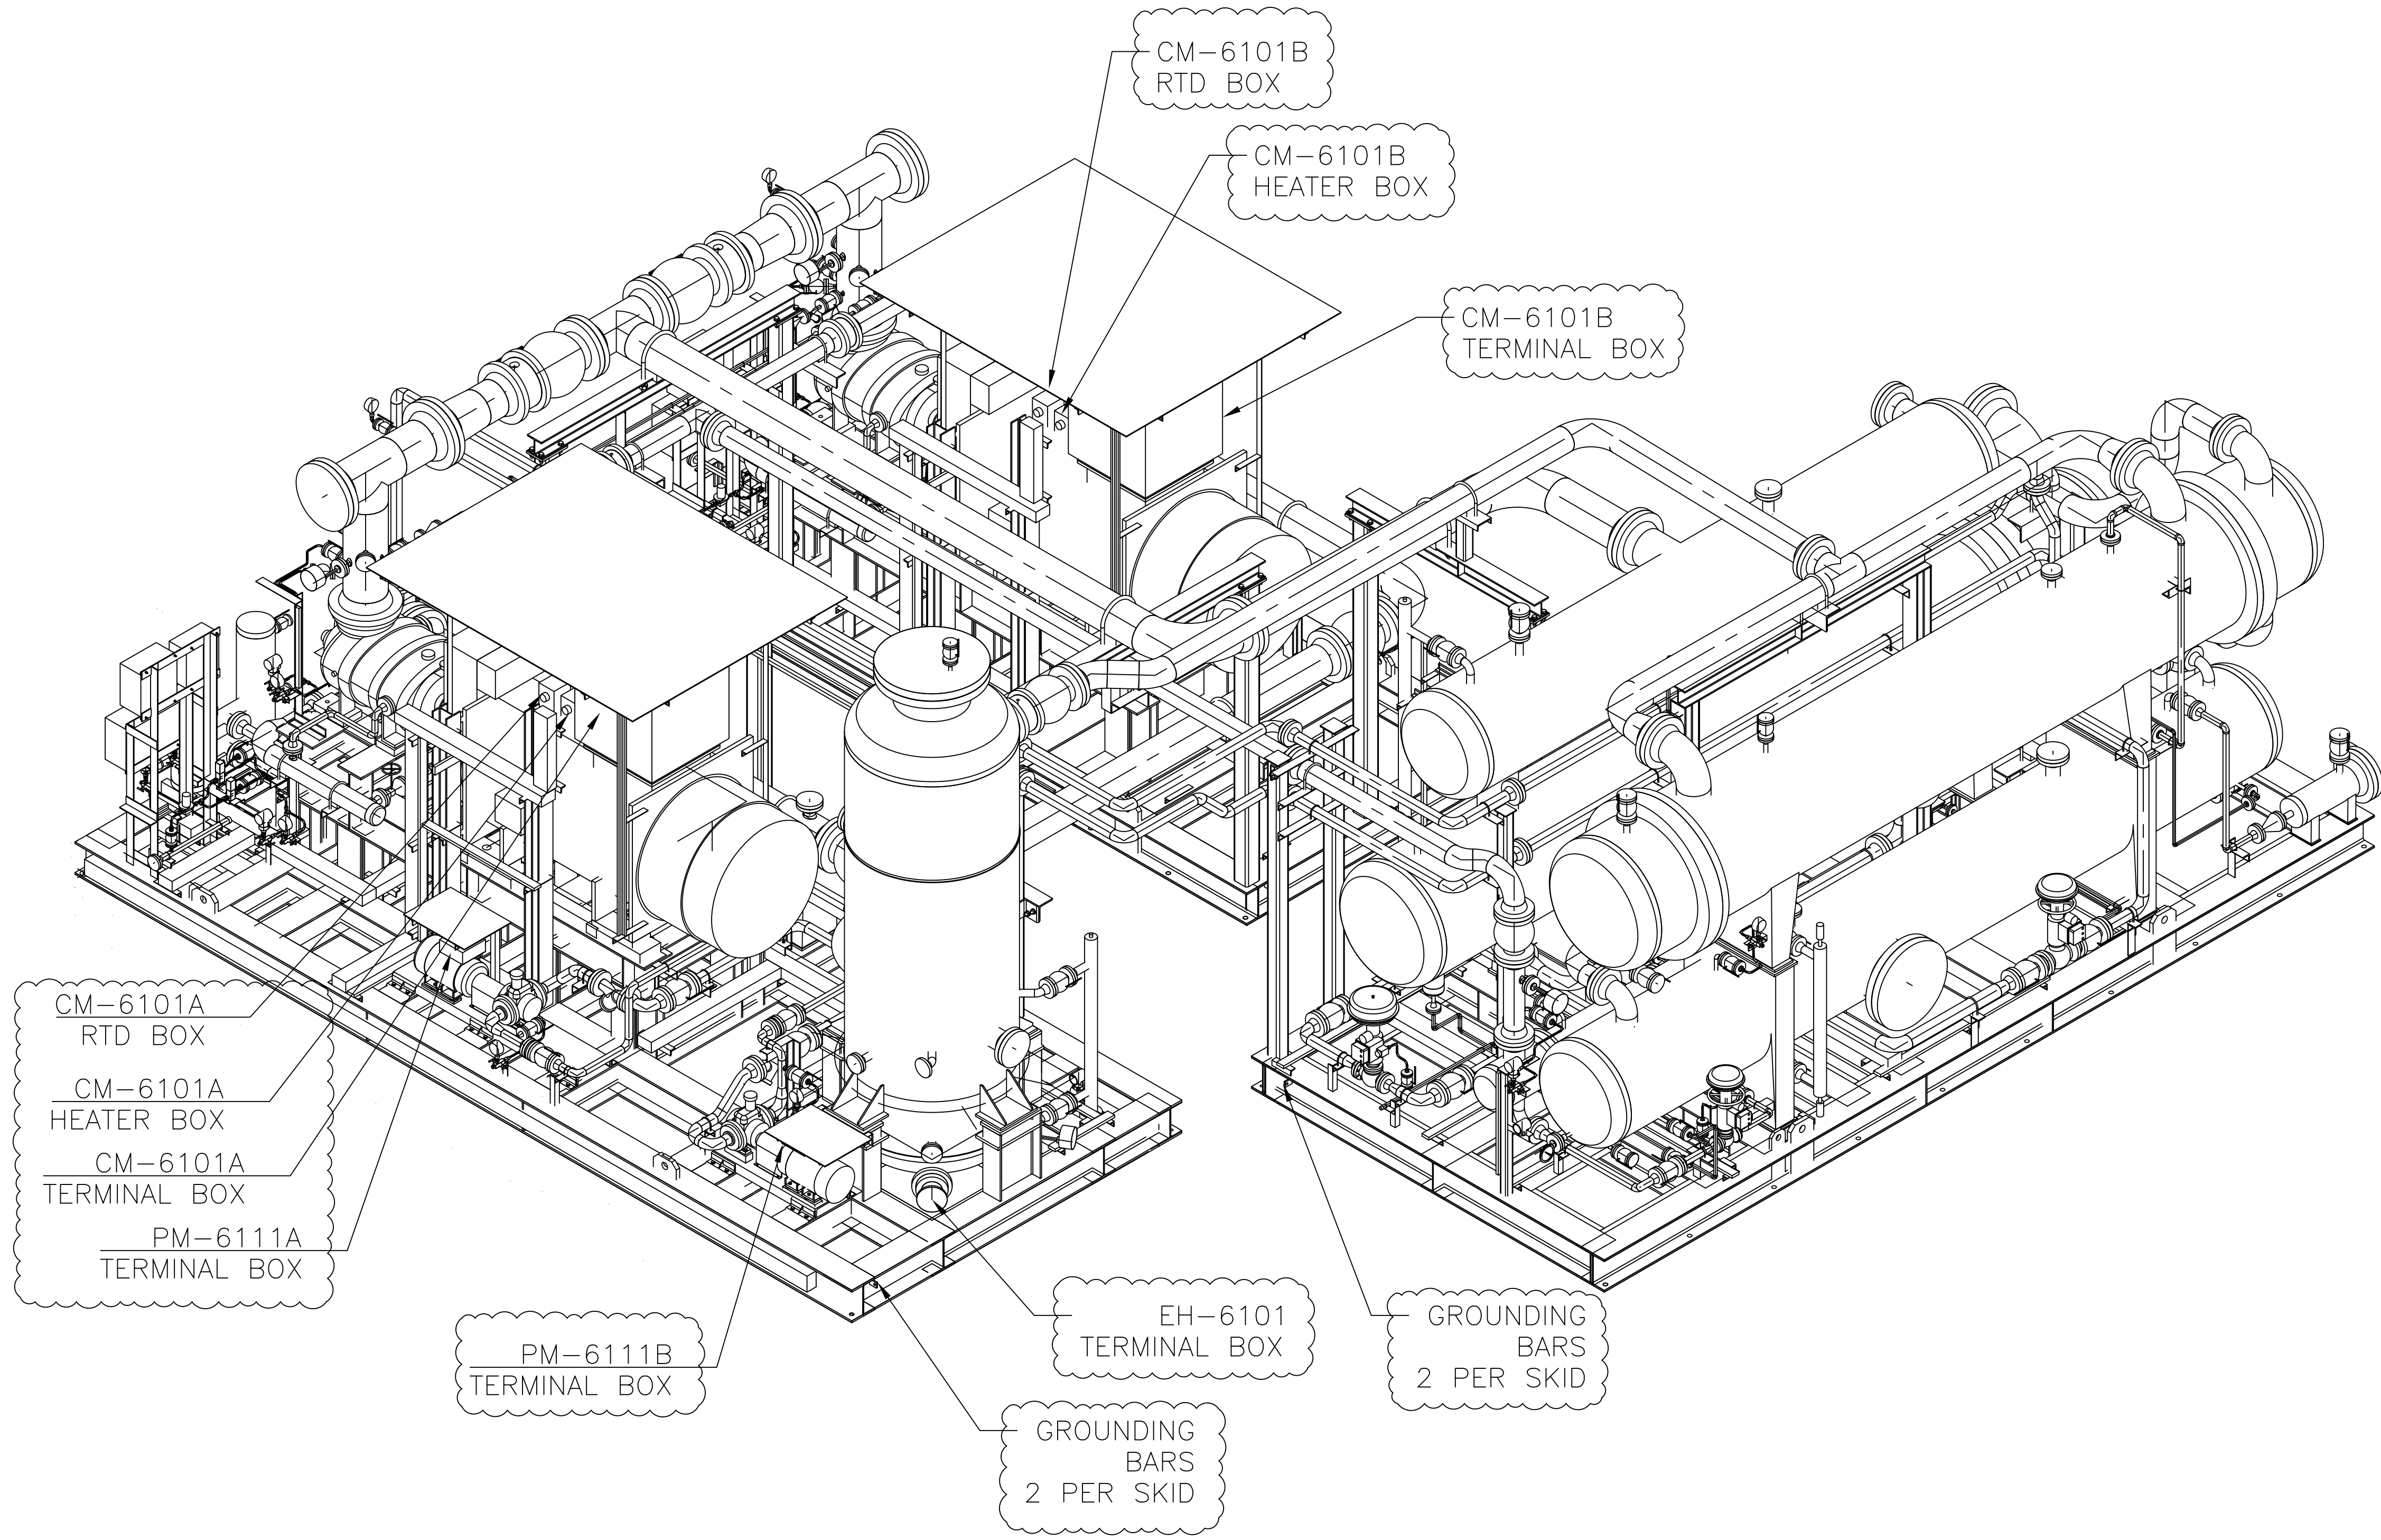



Code1	<input type="checkbox"/> No Comment/ Approved (Applicable Only for "FOR REVIEW" and "For Approval" Documents) No comment and the document one released for Manufacturing				
Code2	<input type="checkbox"/> No Comment / Approved with Note(s) Vendor/Sub-Contractor shall correct, revise and resubmit the document. The document is released for Manufacturing if changes incorporated.				
Code3	<input type="checkbox"/> Commented Vendor/Sub-Contractor shall correct, revise and resubmit the document by the date specified. The document shall be revised under the Status of "R: Revised Issue". All corrected documents shall be resubmitted before starting the Manufacturing Process				
Code4	<input type="checkbox"/> Not Accepted (Rejected) Vendor/Sub-Contractor shall re-work/re-design/re-specify the contents of the document according to the comments/reasons for rejection. All corrected documents shall be resubmitted before starting the manufacturing. Vendor/Sub-Contractor shall not proceed with subsequent works of Material Supply or Manufacturing unit receiving Code1/Code2 or No Code from PURCHASER. Vendor/Sub-Contractor shall resubmit the document with the same revision within 6 working days after receiving comments				
No Code	<input type="checkbox"/> No Code (Only for "For Information" Documents and "As Built DWG") Document has been submitted for PURCHASER'S information (FI). Considering completeness and correctness of document content is in Vendor/Sub-Contractor's responsibility.				
The above checking result by EIED shall in no way relieve Vendor of any liability, obligation and responsibility out of the purchase order and the mutual agreement in writing.					
DATE : DEPT : Signature :					
CV	PI	EL	IN	ME	MA
ST	BU	PR	SA	HV	TL

04	20.02.2026	IFA	FA	IM	OG
03	13.12.2025	IFA	FA	IM	OG
02	30.09.2025	IFA	FA	IM	OG
01	14.09.2025	IFA	FA	IM	OG
00	15.06.2025	IFA	FA	IM	OG
REV.	DATE (DD.MM.YY)	Purpose of Issue	Prepared	Checked	Approved




		Gacharan Polymer Industries Company HDPE Plant	
		CONTRACT NO.: GPI--CON--99--008	
PO No.: xxxxxx		SCALE: 3/8":1'	

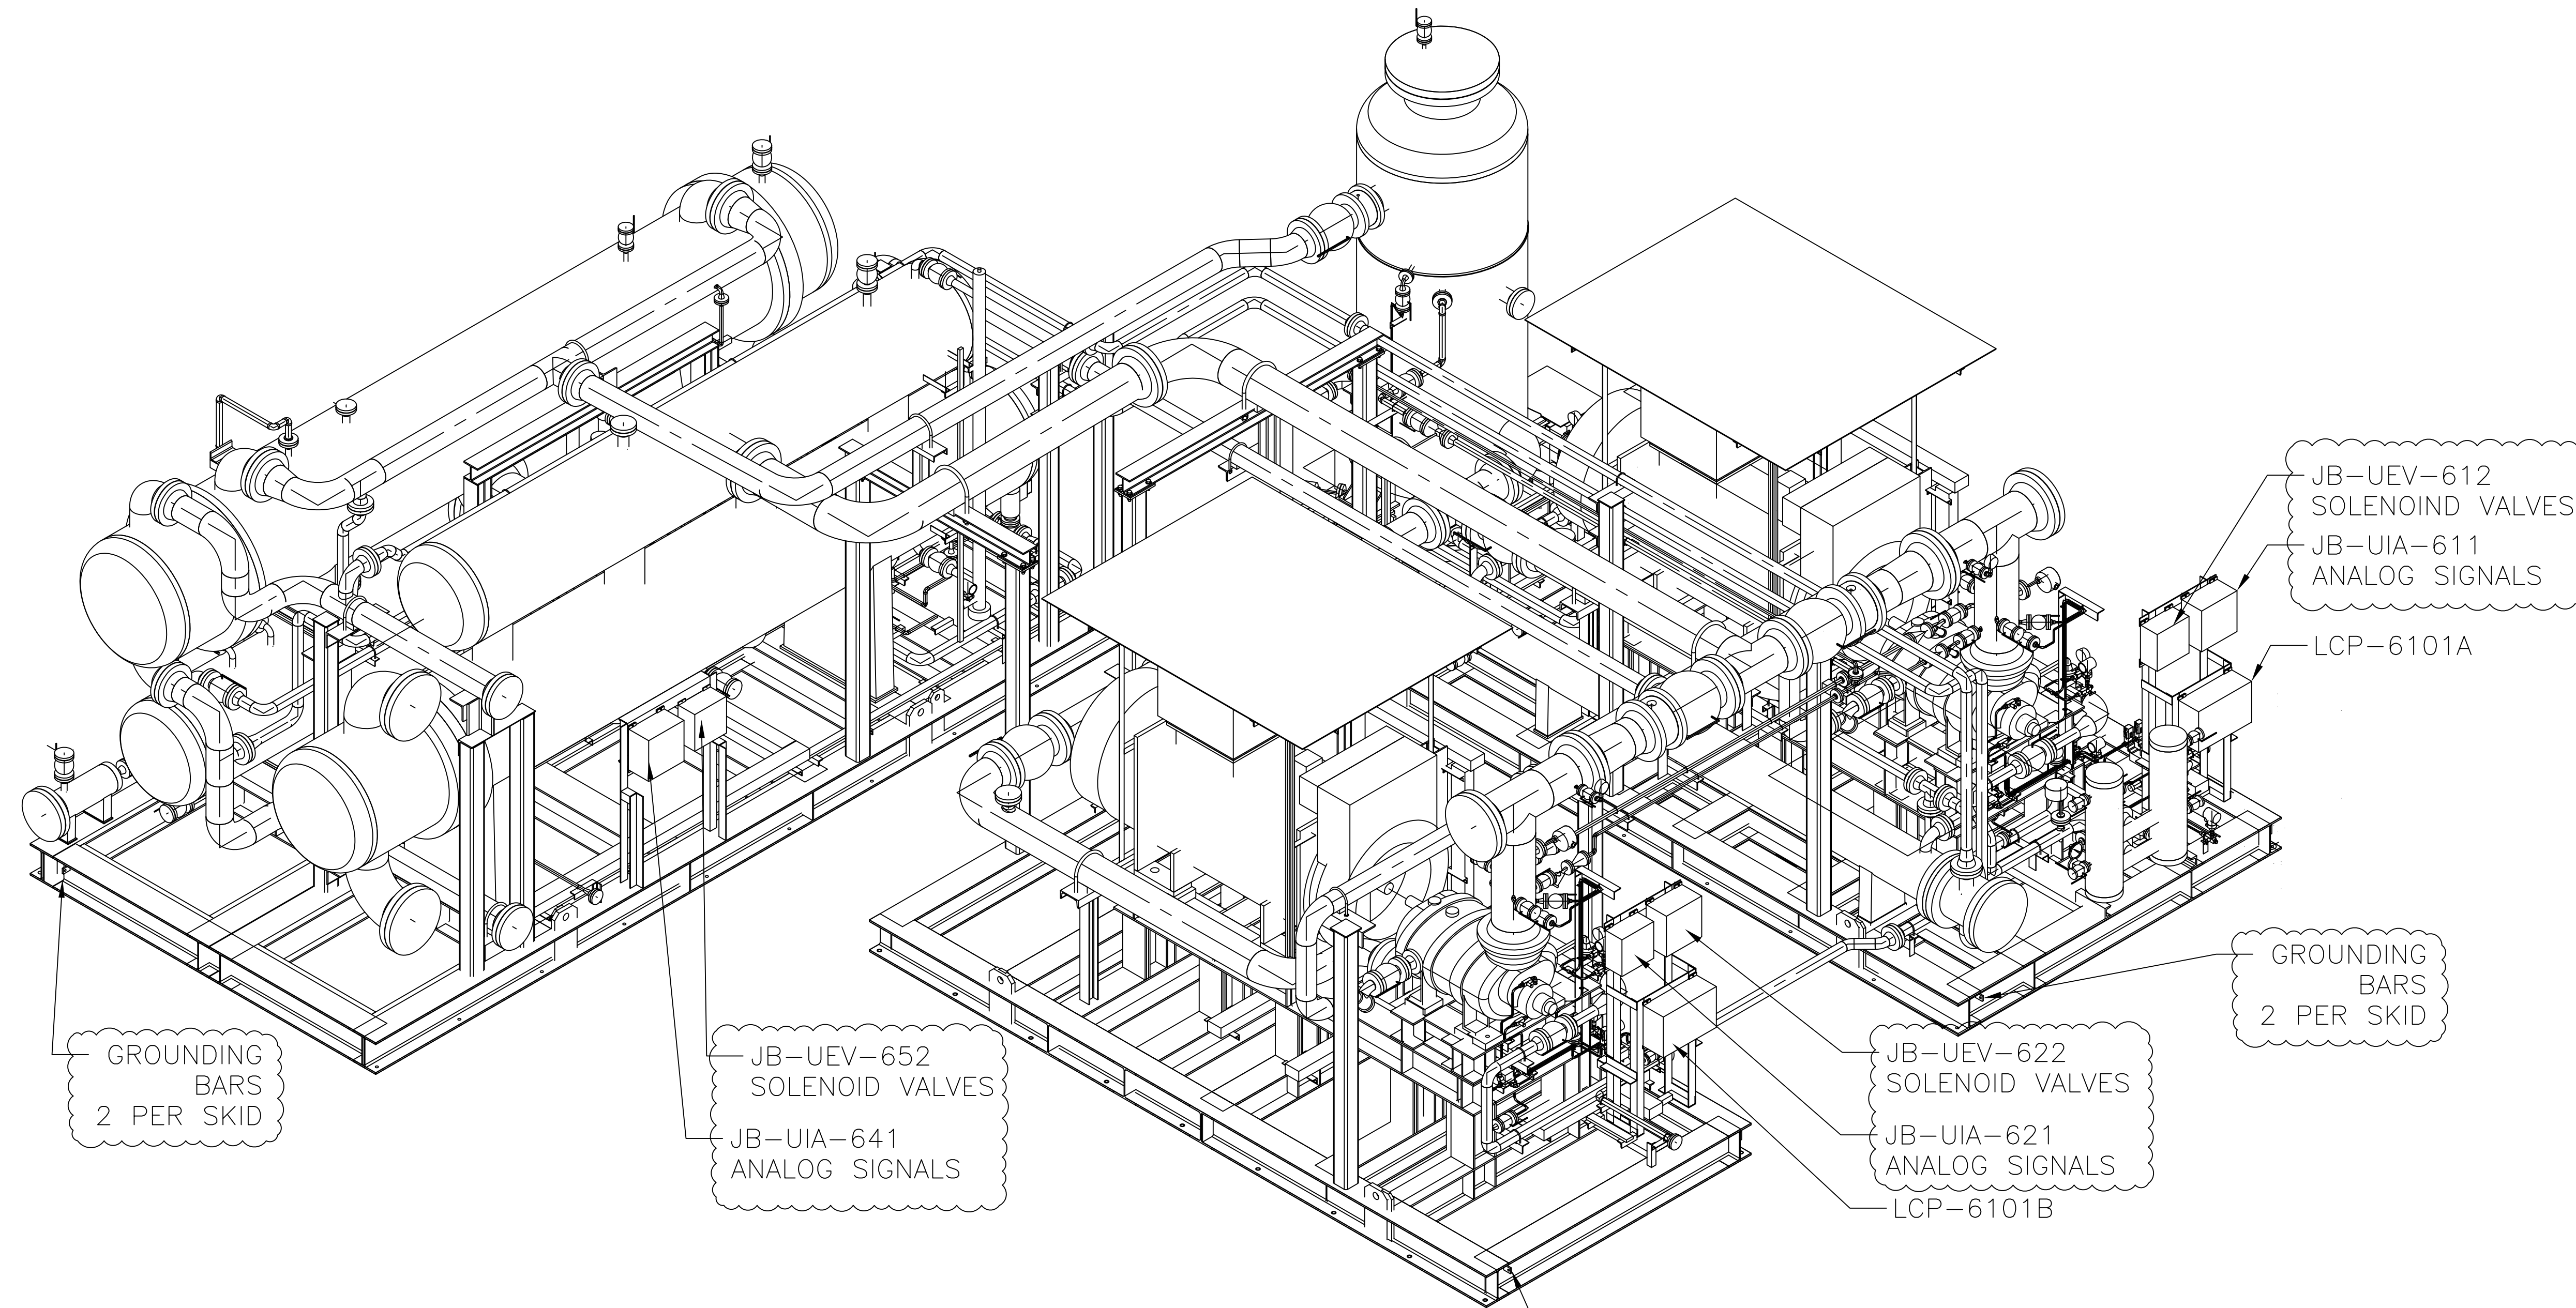
DRAWING TITLE: GENERAL ARRANGEMENT DRAWING			
DRAWING NO. VD-GPIC-MA-3029-3029-0062	REV. 04	SHEET NO. 7 OF 9	SIZE A1




Code1	<input type="checkbox"/> No Comment/ Approved (Applicable Only for "FOR REVIEW" and "For Approval" Documents) No comment and the document are released for Manufacturing.				
Code2	<input type="checkbox"/> No Comment / Approved with Note(s) Vendor/Sub-Contractor shall correct, revise and resubmit the document. The document is released for Manufacturing if changes incorporated.				
Code3	<input type="checkbox"/> Commented Vendor/Sub-Contractor shall correct, revise and resubmit the document by the date specified. The document shall be revised under the Status of "R: Revised Issue". All corrected documents shall be resubmitted before starting the Manufacturing Process.				
Code4	<input type="checkbox"/> Not Accepted (Rejected) Vendor/Sub-Contractor shall re-work/re-design/re-specify the contents of the document according to the comments/reasons for rejection. All corrected documents shall be resubmitted before starting the manufacturing. Vendor/Sub-Contractor shall not proceed with subsequent works of Material Supply or Manufacturing until receiving Code1/Code2 or No Code from PURCHASER. Vendor/Sub-Contractor shall resubmit the document with the same revision within 6 working days after receiving comments.				
No Code	<input type="checkbox"/> No Code (Only for "For Information" Documents and "As Built DWGs") Document has been submitted for PURCHASER'S Information (FI). Considering completeness and correctness of document content is in Vendor/Sub-Contractor's responsibility.				
The above checking result by EIED shall in no way relieve Vendor of any liability, obligation and responsibility out of the purchase order and the mutual agreement in writing.					
 DATE : DEPT: Signature :					
CV	PI	EL	IN	ME	MA
ST	BU	PR	SA	HY	TL



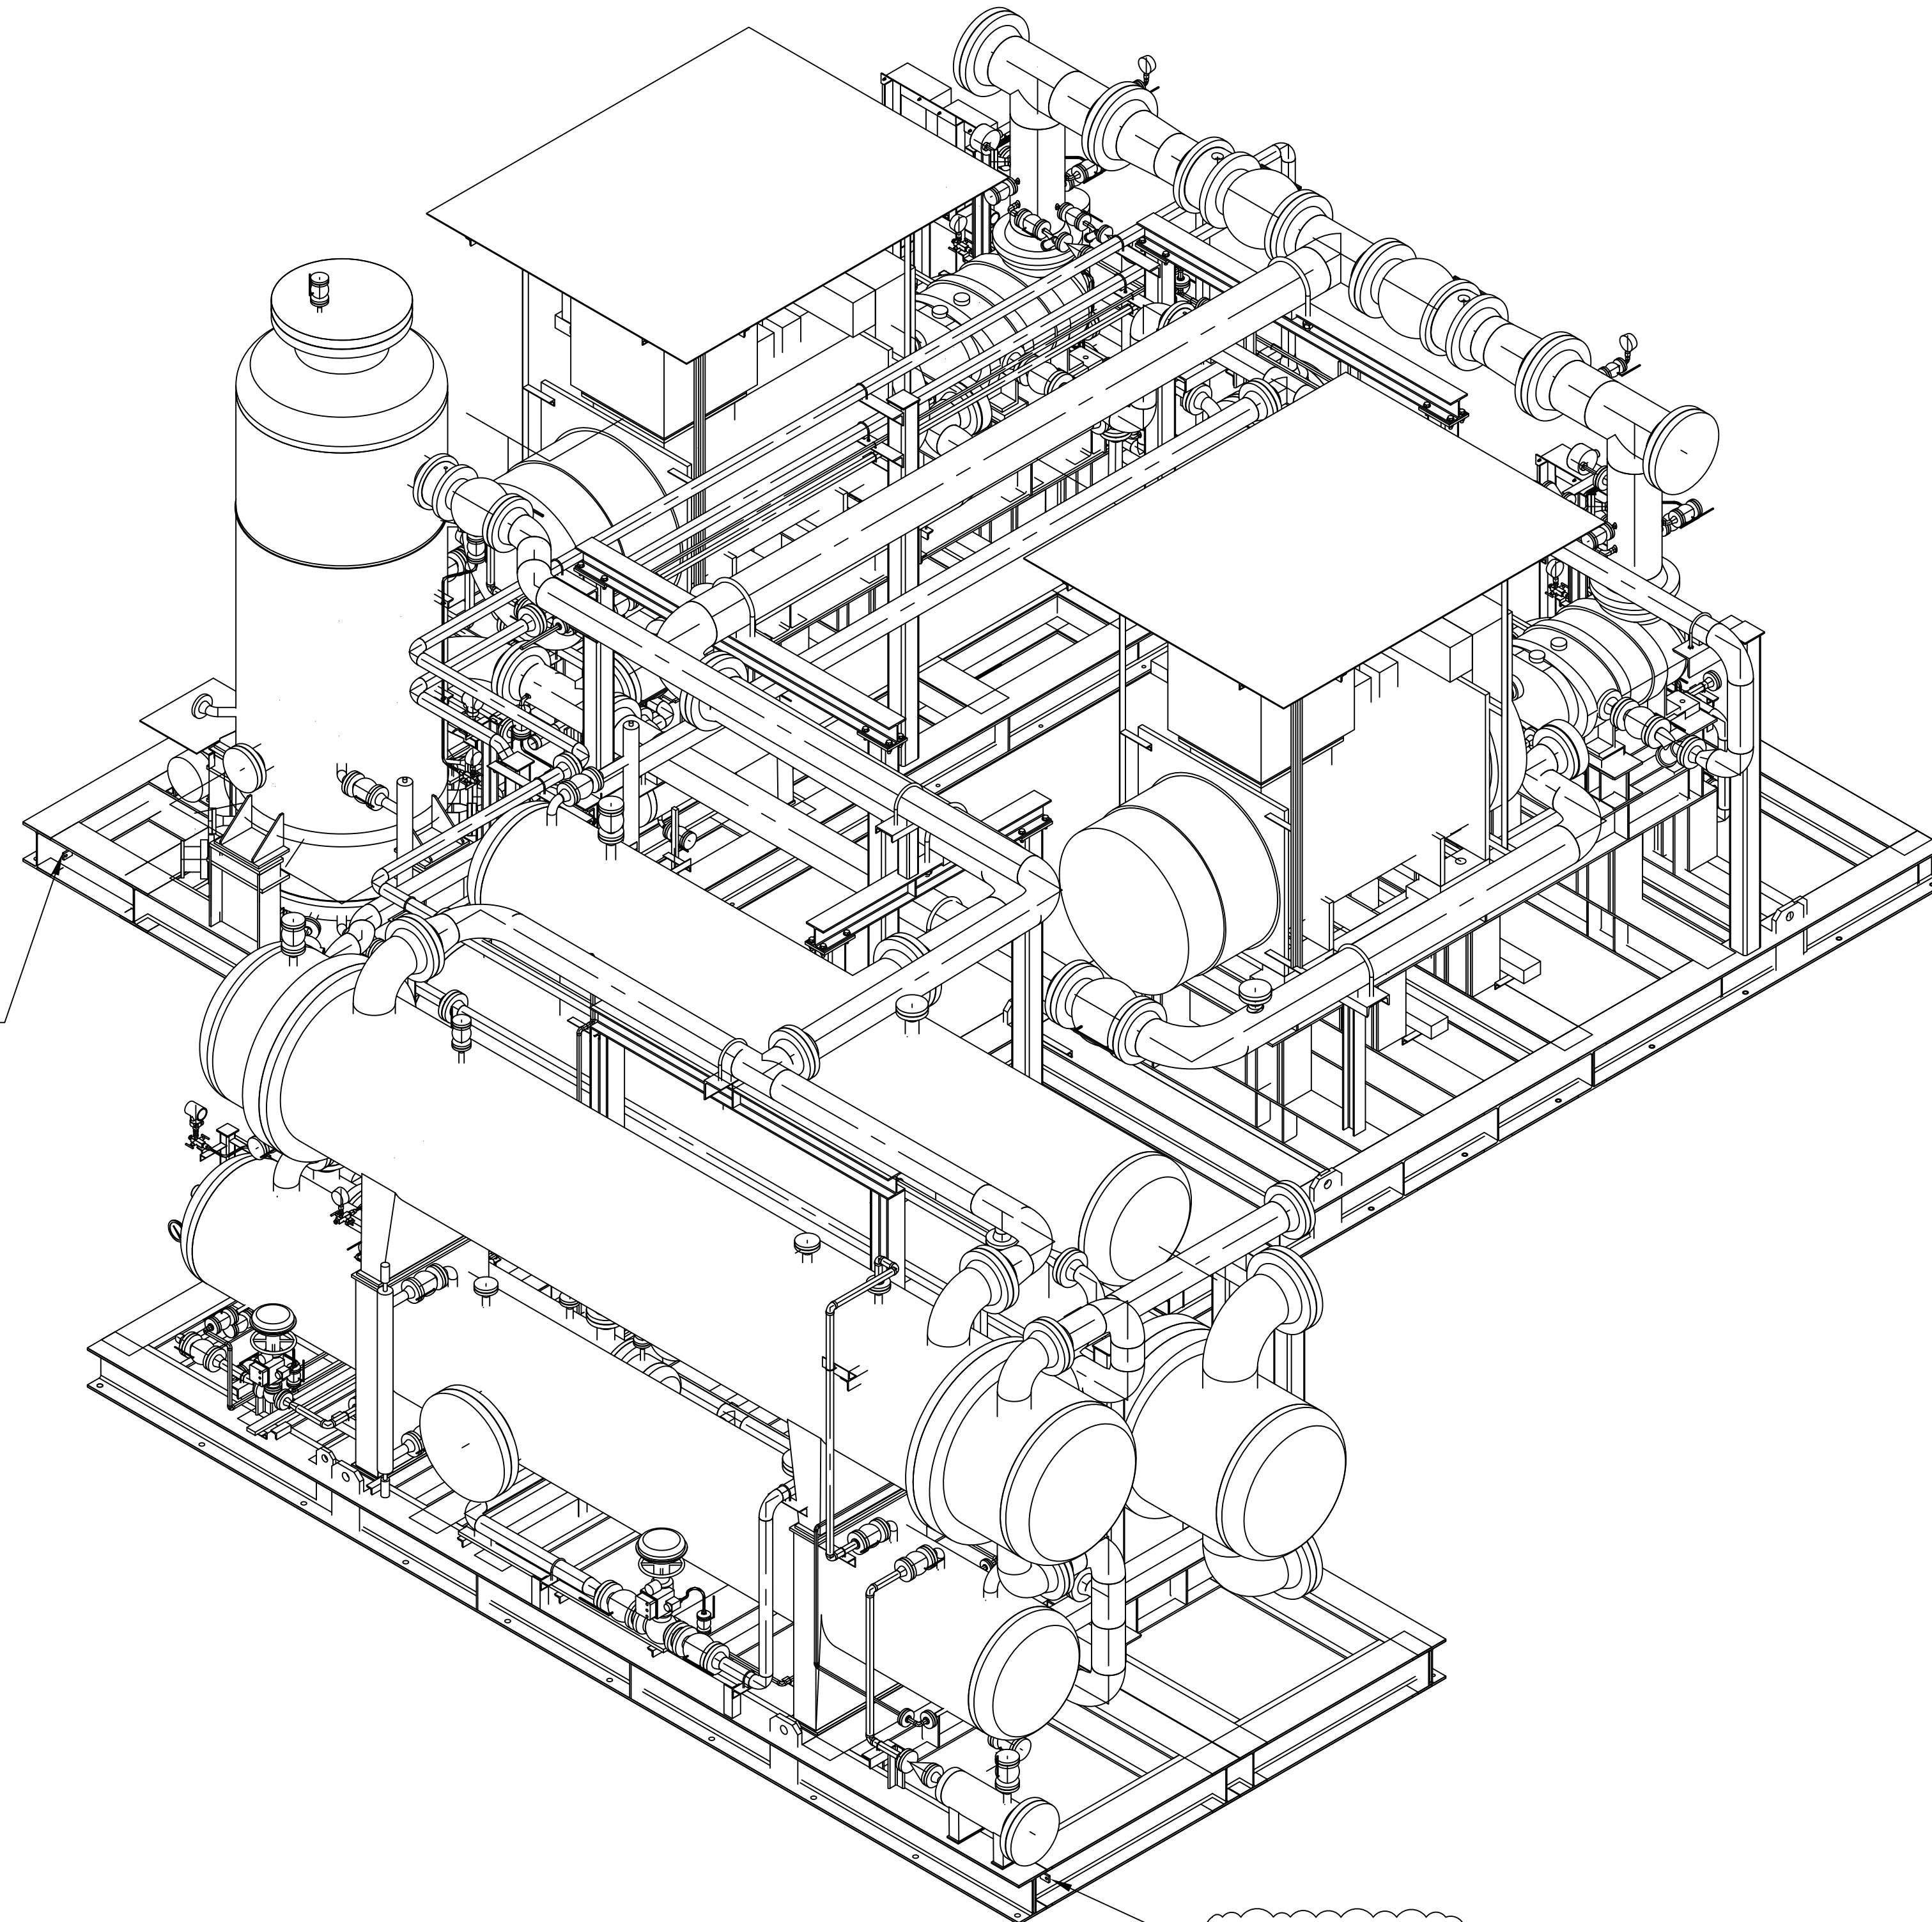

04	20.02.2026	IFA	FA	IM	OG
03	13.12.2025	IFA	FA	IM	OG
02	30.09.2025	IFA	FA	IM	OG
01	14.09.2025	IFA	FA	IM	OG
00	15.06.2025	IFA	FA	IM	OG
REV.	DATE (DD.MM.YY)	Purpose of Issue	Prepared	Checked	Approved

 Gachsaran Polymer Industries Company	 Gachsaran Polymer Industries Company HDPE Plant	 EIED  DELTA PROCESS EQUIPMENT	
			CONTRACT NO.: GPI--CON--99--008
PO No.: xxxxxx			
DRAWING TITLE: GENERAL ARRANGEMENT DRAWING			
DRAWING NO. VD-GPIC-MA-3029-3029-0062	REV. 04	SHEET NO. 8 OF 9	SIZE A1



Code1	<input type="checkbox"/> No Comment/ Approved (Applicable Only for "FOR REVIEW" and "For Approval" Documents) No comment and the document are released for Manufacturing				
Code2	<input type="checkbox"/> No Comment / Approved with Note(s) Vendor/Sub-Contractor shall correct, revise and resubmit the document. The document is released for Manufacturing if changes incorporated.				
Code3	<input type="checkbox"/> Commented Vendor/Sub-Contractor shall correct, revise and resubmit the document by the date specified. The document shall be revised under the Status of "R: Revised Issue". All corrected documents shall be resubmitted before starting the Manufacturing Process				
Code4	<input type="checkbox"/> Not Accepted (Rejected) Vendor/Sub-Contractor shall re-work/re-design/re-specify the contents of the document according to the comments/reasons for rejection. All corrected documents shall be resubmitted before starting the manufacturing. Vendor/Sub-Contractor shall not proceed with subsequent works of Material Supply or Manufacturing unit receiving Code1/Code2 or No Code from PURCHASER. Vendor/Sub-Contractor shall resubmit the document with the same revision within 6 working days after receiving comments				
No Code	<input type="checkbox"/> No Code (Only for "For Information" Documents and "As Built DWGs") Document has been submitted for PURCHASER's Information (I). Considering completeness and correctness of document content is in Vendor/Sub-Contractor's responsibility. The above checking result by EIED shall in no way relieve Vendor of any liability, obligation and responsibility out of the purchase order and the mutual agreement in writing.				
 DATE : _____ DEPT: _____ Signature : _____					
CV	PI	EL	IN	ME	MA
ST	BU	PR	SA	HV	TL

04	20.02.2026	IFA	FA	IM	OG
03	13.12.2025	IFA	FA	IM	OG
02	30.09.2025	IFA	FA	IM	OG
01	14.09.2025	IFA	FA	IM	OG
00	15.06.2025	IFA	FA	IM	OG
REV.	DATE (DD.MM.YY)	Purpose of Issue	Prepared	Checked	Approved

 Gachsaran Polymer Industries Company	 Gachsaran Plyomer Industries Company HDPE Plant	  DELTA PROCESS EQUIPMENT
CONTRACT NO.: GPI--CON--99--008		SCALE: 3/8":1'
PO No.: xxxxxx DRAWING TITLE: GENERAL ARRANGEMENT DRAWING		
DRAWING NO. VD-GPIC-MA-3029-3029-0062	REV. 04	SHEET NO. 9 OF 9
		SIZE A1

