

Loop diagrams

Document No. 17735-30

Project No.	Vendor Doc.	P.O. No.	Department	Document Type	Serial No	Revision	Page
N278	VD	6019	EL	DIA	0031	03	Page 1 of 22

**Airpack B.V. - Air Compressor –  
Integrated Methanol and Ammonia Plant  
17735-COM Loop diagrams (K020)**

This document should be updated as per latest comment on wiring diagram LCP and JB document.

03	14-02-2024	Issued for Approval	R.T.	S.K.	J.J.
02	21-12-2023	Issued for Approval	R.T.	S.K.	J.J.
01	07-12-2023	Issued for Approval	R.T.	S.K.	J.J.
REV.	DATE	DESCRIPTION	DRAWN	CHECKED	APPROVED

Loop diagrams

Document No. 17735-30

Project No.	Vendor Doc.	P.O. No.	Department	Document Type	Serial No	Revision	Page
N278	VD	6019	EL	DIA	0031	03	Page 2 of 22

LIST OF REVISED PAGES

Rev. Page	01	02	03	04	05	Rev. Page	01	02	03	04	05	Rev. Page	01	02	03	04	05	Rev. Page	01	02	03	04	05
1	X	X	X			26						51						76					
2	X	X	X			27						52						77					
3	X	X	X			28						53						78					
4	X	X	X			29						54						79					
5	X	X	X			30						55						80					
6	X	X	X			31						56						81					
7	X	X	X			32						57						82					
8	X	X	X			33						58						83					
9	X	X	X			34						59						84					
10	X	X	X			35						60						85					
11	X	X	X			36						61						86					
12	X	X	X			37						62						87					
13	X	X	X			38						63						88					
14	X	X	X			39						64						89					
15	X	X	X			40						65						90					
16	X	X	X			41						66						91					
17	X	X	X			42						67						92					
18	X	X	X			43						68						ATTACHMENT					
19	X	X	X			44						69						1					
20	X	X	X			45						70						2					
21	X	X	X			46						71						3					
22	X	X	X			47						72						4					
23						48						73						5					
24						49						74						6					
25						50						75						7					



# Airpack B.V.

4301 RN Zierikzee  
The Netherlands

PHONE: (31) (0) 111 - 415455

FAX: (31) (0) 111 - 413338

E-MAIL : AIRPACK@AIRPACK.NL

WEBPAGE : WWW.AIRPACK.NL

Client	:	LAVAN INDUSTRY DEVELOPMENT COMPANY (LIDCO)		
Equipment location	:	IRAN, ONSHORE		
Client reference	:	INTEGRATED METHANOL AND AMMONIA PLANT		
Client dwg. no.	:	N-278-VD-6019-EL-DIA-0031-01		
Airpack reference	:	17735-30 Loop Diagrams		
Airpack dwg. no.	:	17735-30		
Generation date	:	2023-12-07		
E & I manager	:	RBE	Revision no.	: 03
Last modifications	:	2024-02-14		
Last modifications by	:	RTR		



CLIENT DWG NO.	N-278-VD-6019-EL-DIA-0031-01
EQUIPMENT NO.	320-K-020
EQUIPMENT LOCATION	IRAN, ONSHORE
THIS DRAWING IS OWNED BY AIRPACK, AND SHALL NOT BE PRINTED OR COPIED IN ANY OTHER WAY THAN WITH AIRPACKS PERMISSION!	

SUBJECT	
Title page / cover sheet	
ADAPTED TO P&ID REVISION	07
CLIENT	LAVAN INDUSTRY DEVELOPMENT COMPANY (LIDCO)
CLIENT REF.	INTEGRATED METHANOL AND AMMONIA PLANT
AIRPACK REF.	17735-30 Loop Diagrams

DRAWN BY	RTR	=
CHECKED BY	RBE	+
LAST MODIFICATION DATE	2023-12-20	CURRENT PAGE
AIRPACK DWG NO.	17735-30	
REVISION	03	
TOTAL PAGE AMOUNT	1	

# COMMENTS ON ELECTRICAL DRAWINGS

LPS AND JB MOUNTED ON SKID  
 MATERIAL: SHEET STEEL  
 INGRESS. PROTECTION: IP-65  
 AREA CLASSIFICATION: SAFE

GLANDS: SS316 GLANDS WITH SHROUDS, IP-66  
 CABLE TRAYS: HOT-DIP GALVANIZED

AMBIENT TEMPERATURE: 0 / 49 °C

ALL "IE" CONNECTIONS WILL BE CONNECTED ON A "IE"-BAR

REFERENCE DOCUMENTS:

- 17735-03 - N-278-VD-6019-PR-PID-0002-~~01~~ - P&ID
- 17735-06 - N-278-VD-6019-IN-LIS-0006-~~01~~ - I/O List
- 17735-07 - N-278-VD-6019-IN-DWG-0007-~~01~~ - Outline Dimensional Drawings for LCP Panel and Junction Box
- 17735-21 - N-278-VD-6019-GN-PRO-0022-~~01~~ - Control Philosophy

 








SIGNAL PAIRS	
CURRENT LOOPS	POSITIVE: BLACK NEGATIVE: WHITE
VOLT [FREE] CONTACTS	POSITIVE: BLACK NEGATIVE: BLACK

As per latest VPIS, "01" is removed from all document No.



CLIENT DWG NO.	N-278-VD-6019-EL-DIA-0031-01	SUBJECT	Project description	DRAWN BY	RTR	=
EQUIPMENT NO.	320-K-020	ADAPTED TO P&ID REVISION	07	CHECKED BY	RBE	+
EQUIPMENT LOCATION	IRAN, ONSHORE	CLIENT	LAVAN INDUSTRY DEVELOPMENT COMPANY (LIDCO)	LAST MODIFICATION DATE	2023-12-20	CURRENT PAGE
THIS DRAWING IS OWNED BY AIRPACK, AND SHALL NOT BE PRINTED OR COPIED IN ANY OTHER WAY THAN WITH AIRPACKS PERMISSION!		CLIENT REF.	INTEGRATED METHANOL AND AMMONIA PLANT	AIRPACK DWG NO.	17735-30	
		AIRPACK REF.	17735-30 Loop Diagrams	REVISION	03	
				TOTAL PAGE AMOUNT	2	

# SYMBOL LEGEND

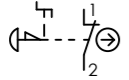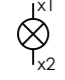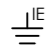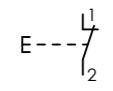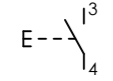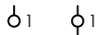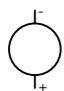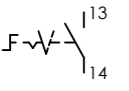SYMBOL	DESCRIPTION	SYMBOL	DESCRIPTION
	CABLE SHIELD		
	EMERGENCY STOP		
	INDICATION LAMP		
	INSTRUMENT EARTH CONNECTION POINT		
	N/C PUSHBUTTON		
	N/O PUSHBUTTON		
	TERMINAL CONNECTION POINT		
	TRANSMITTER CONNECTION POINT		
	TWO-POSITION SELECTOR SWITCH		

# 300LP-820

## LOCAL PUSHBUTTON STATION




CLIENT DWG NO.	N-278-VD-6019-EL-DIA-0031-01	SUBJECT		DRAWN BY	RTR	= 320-K-020
EQUIPMENT NO.	320-K-020	PANEL DESCRIPTION		CHECKED BY	RBE	+ 300LP-820
EQUIPMENT LOCATION	IRAN, ONSHORE	ADAPTED TO P&ID REVISION	07	LAST MODIFICATION DATE	2023-12-20	CURRENT PAGE
THIS DRAWING IS OWNED BY AIRPACK, AND SHALL NOT BE PRINTED OR COPIED IN ANY OTHER WAY THAN WITH AIRPACKS PERMISSION!		CLIENT	LAVAN INDUSTRY DEVELOPMENT COMPANY (LIDCO)	AIRPACK DWG NO.	17735-30	
		CLIENT REF.	INTEGRATED METHANOL AND AMMONIA PLANT	REVISION	03	
		AIRPACK REF.	17735-30 Loop Diagrams	TOTAL PAGE AMOUNT	4	


# Loop Diagrams

Internal targets

=320-K-020+300LP-820-300CDDN820

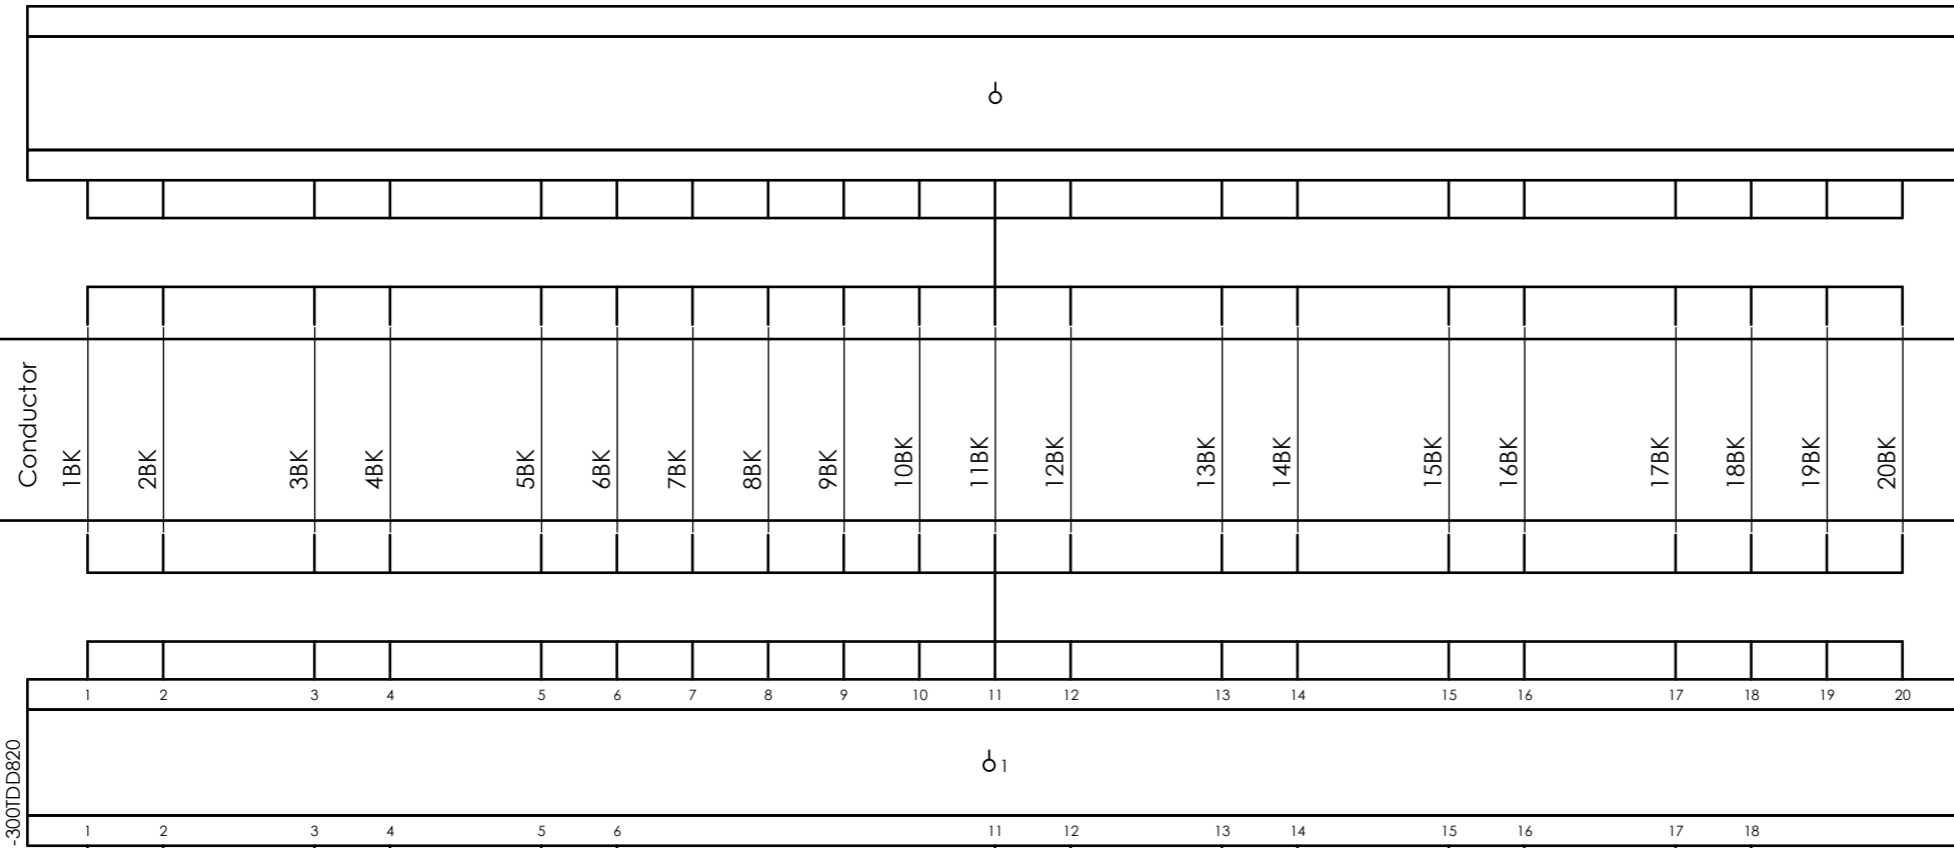

External targets

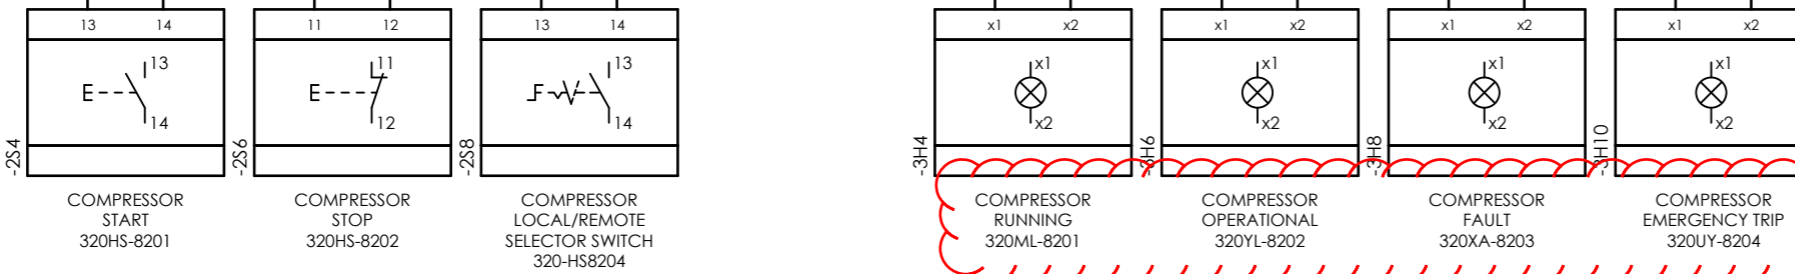

CLIENT DWG NO.	N-278-VD-6019-EL-DIA-0031-01
EQUIPMENT NO.	320-K-020
EQUIPMENT LOCATION	IRAN, ONSHORE
THIS DRAWING IS OWNED BY AIRPACK, AND SHALL NOT BE PRINTED OR COPIED IN ANY OTHER WAY THAN WITH AIRPACKS PERMISSION!	

SUBJECT	
Cable-connection diagram =320-K-020+300LP-820-300CDDN820	
ADAPTED TO P&ID REVISION	07
CLIENT	LAVAN INDUSTRY DEVELOPMENT COMPANY (LIDCO)
CLIENT REF.	INTEGRATED METHANOL AND AMMONIA PLANT
AIRPACK REF.	17735-30 Loop Diagrams

DRAWN BY	RTR
CHECKED BY	RBE
LAST MODIFICATION DATE	2023-12-20
AIRPACK DWG NO.	17735-30
REVISION	03
TOTAL PAGE AMOUNT	5

= 320-K-020
+ 300LP-820
CURRENT PAGE

# Loop Diagrams

Internal targets



External targets



CLIENT DWG NO.	N-278-VD-6019-EL-DIA-0031-01
EQUIPMENT NO.	320-K-020
EQUIPMENT LOCATION	IRAN, ONSHORE
THIS DRAWING IS OWNED BY AIRPACK, AND SHALL NOT BE PRINTED OR COPIED IN ANY OTHER WAY THAN WITH AIRPACKS PERMISSION!	

SUBJECT		DRAWN BY		RTR		= 320-K-020	
Cable-connection diagram =320-K-020+300LP-820-300CED820		CHECKED BY		RBE		+ 300LP-820	
ADAPTED TO P&ID REVISION	07	LAST MODIFICATION DATE		2023-12-20		CURRENT PAGE	
CLIENT	LAVAN INDUSTRY DEVELOPMENT COMPANY (LIDCO)	AIRPACK DWG NO.		17735-30			
CLIENT REF.	INTEGRATED METHANOL AND AMMONIA PLANT	REVISION		03			
AIRPACK REF.	17735-30 Loop Diagrams	TOTAL PAGE AMOUNT		6			

# 300JDAN-820 JUNCTION BOX



CLIENT DWG NO.	N-278-VD-6019-EL-DIA-0031-01
EQUIPMENT NO.	320-K-020
EQUIPMENT LOCATION	IRAN, ONSHORE
THIS DRAWING IS OWNED BY AIRPACK, AND SHALL NOT BE PRINTED OR COPIED IN ANY OTHER WAY THAN WITH AIRPACKS PERMISSION!	



SUBJECT PANEL DESCRIPTION	
ADAPTED TO P&ID REVISION	07
CLIENT	LAVAN INDUSTRY DEVELOPMENT COMPANY (LIDCO)
CLIENT REF.	INTEGRATED METHANOL AND AMMONIA PLANT
AIRPACK REF.	17735-30 Loop Diagrams

DRAWN BY	RTR
CHECKED BY	RBE
LAST MODIFICATION DATE	2023-12-20
AIRPACK DWG NO.	17735-30
REVISION	03
TOTAL PAGE AMOUNT	7


= 320-K-020
+ 300JDAN820
CURRENT PAGE

# Loop Diagrams

Internal targets

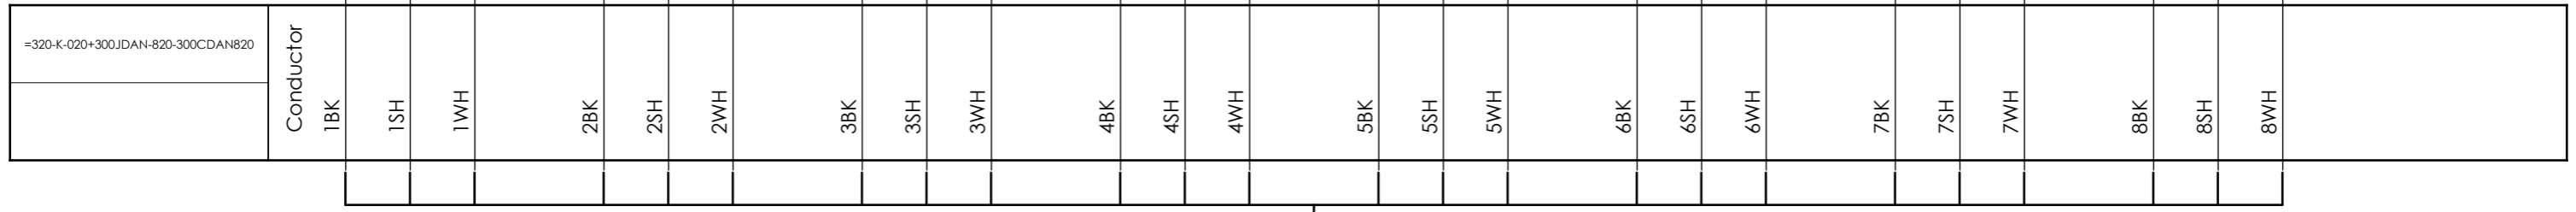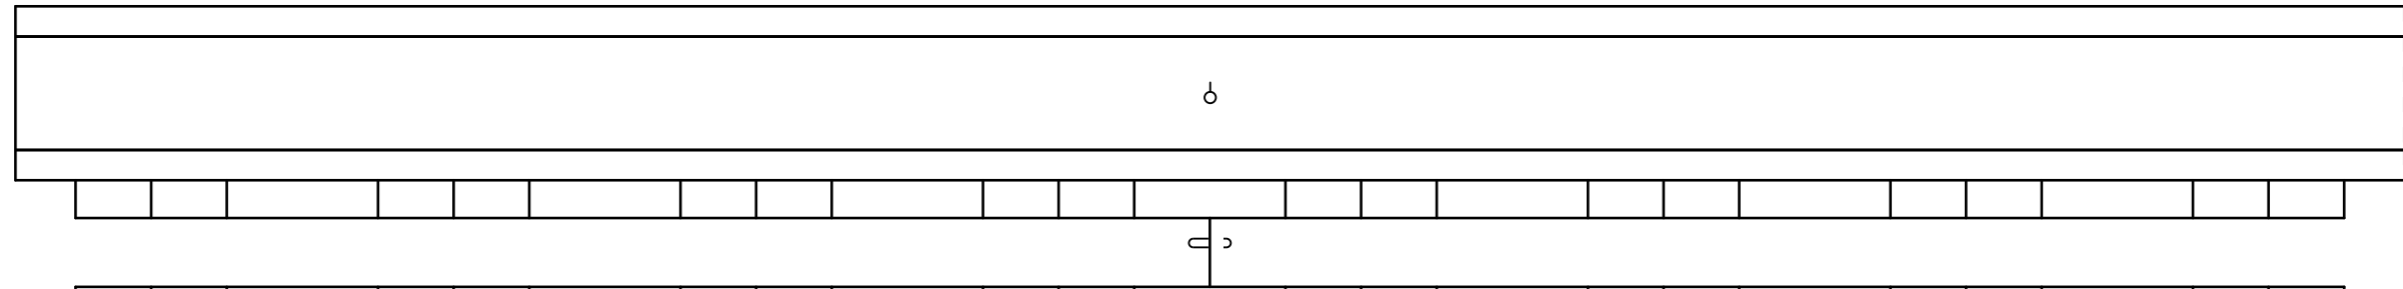

External targets

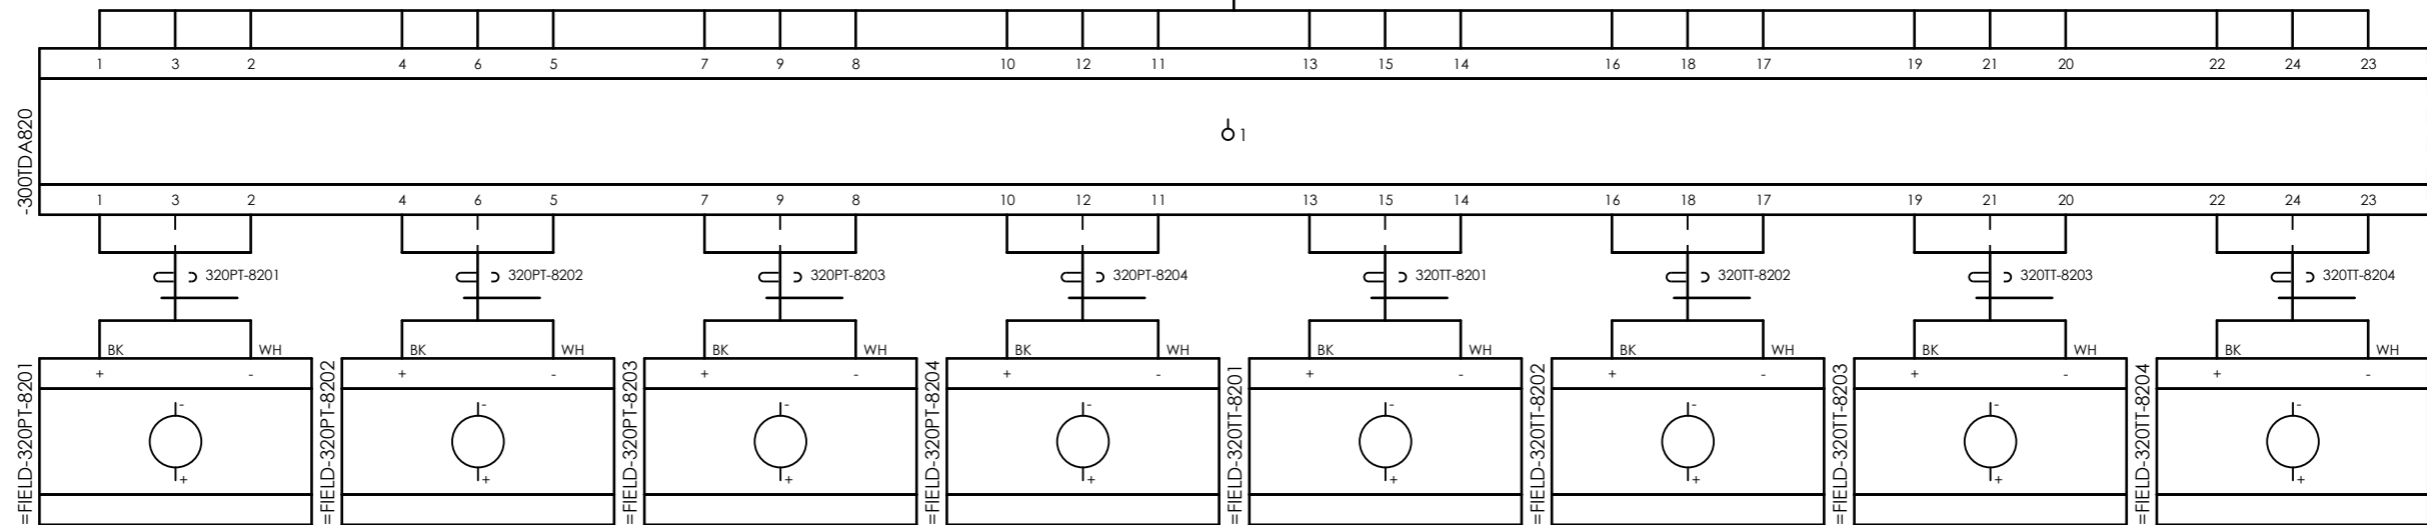


CLIENT DWG NO.	N-278-VD-6019-EL-DIA-0031-01
EQUIPMENT NO.	320-K-020
EQUIPMENT LOCATION	IRAN, ONSHORE
THIS DRAWING IS OWNED BY AIRPACK, AND SHALL NOT BE PRINTED OR COPIED IN ANY OTHER WAY THAN WITH AIRPACKS PERMISSION!	


SUBJECT		DRAWN BY		RTR		= 320-K-020	
Cable-connection diagram =320-K-020+300JDAN-820-300CDAN820		CHECKED BY		RBE		+ 300JDAN820	
ADAPTED TO P&ID REVISION	07	LAST MODIFICATION DATE		2023-12-20		CURRENT PAGE	
CLIENT	LAVAN INDUSTRY DEVELOPMENT COMPANY (LIDCO)	AIRPACK DWG NO.		17735-30			
CLIENT REF.	INTEGRATED METHANOL AND AMMONIA PLANT	REVISION		03			
AIRPACK REF.	17735-30 Loop Diagrams	TOTAL PAGE AMOUNT		8			

# Loop Diagrams

Internal targets

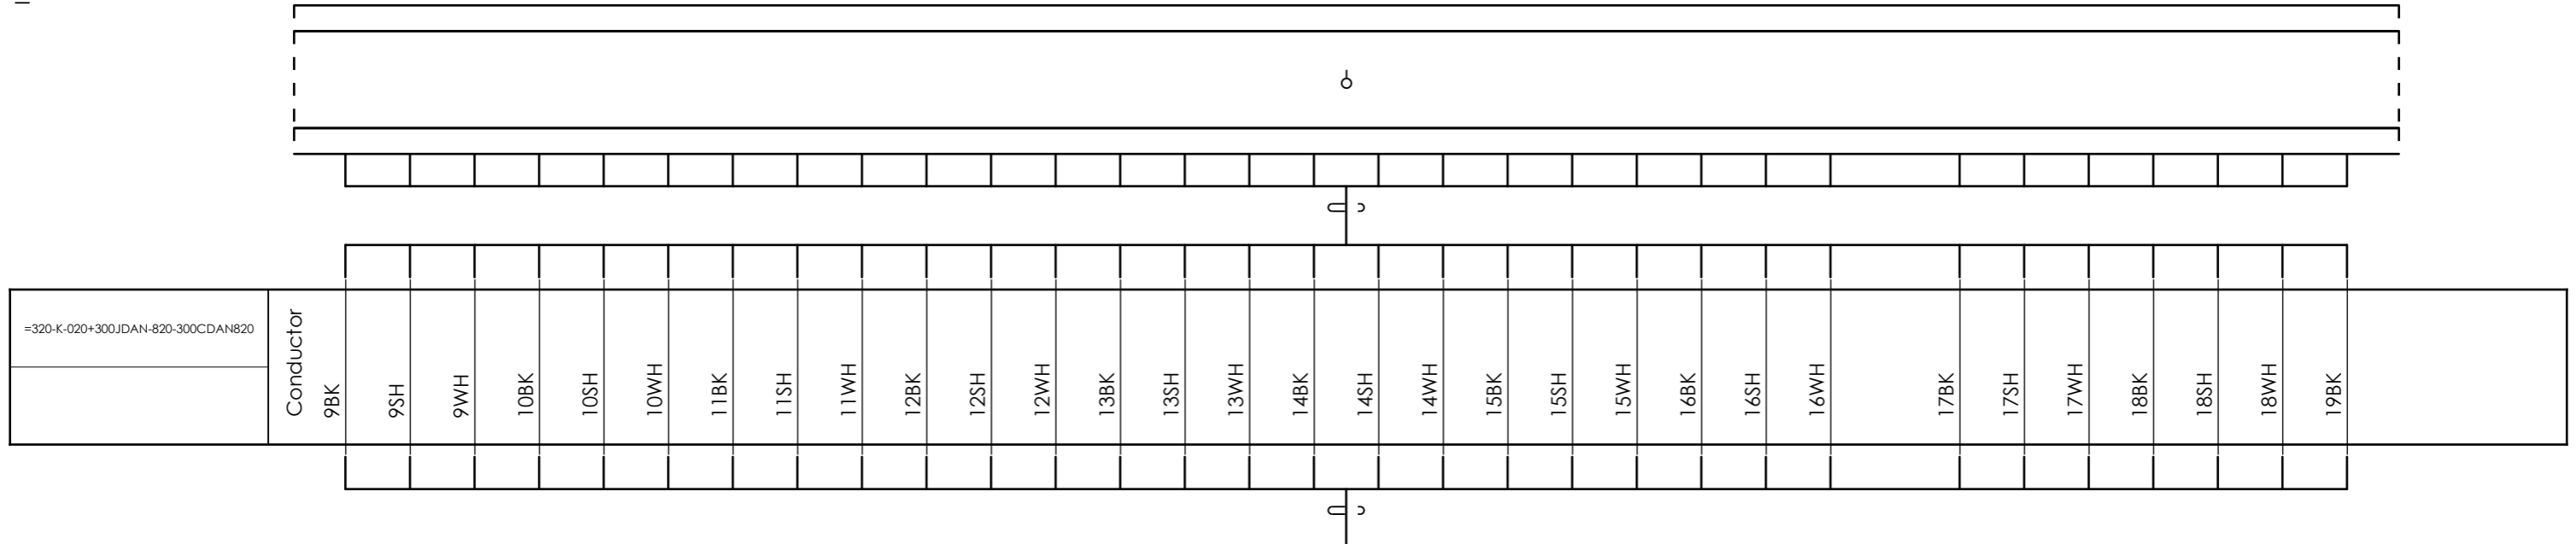

External targets

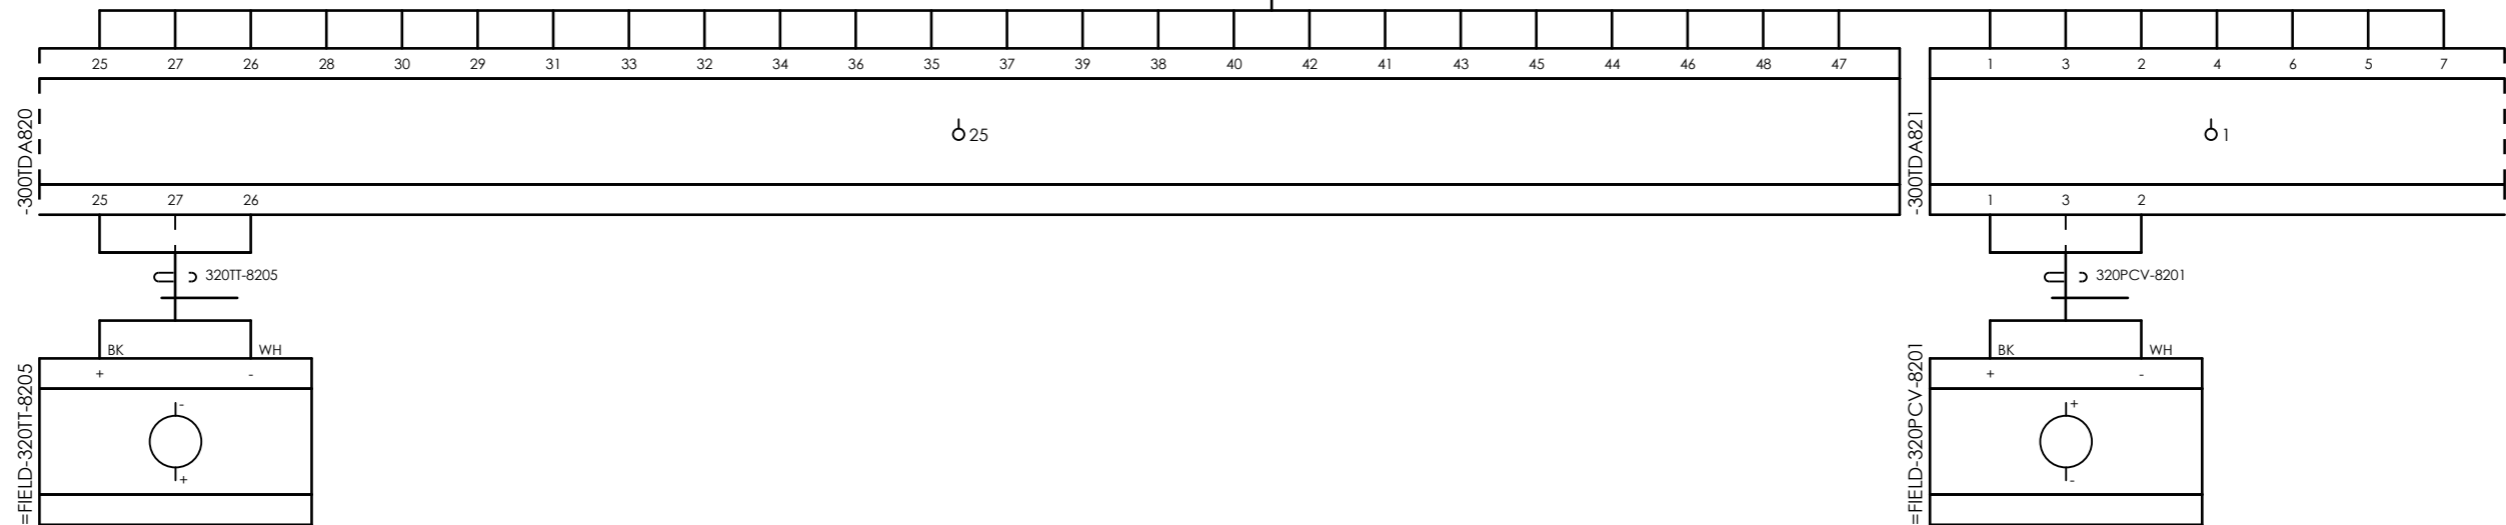

CLIENT DWG NO.	N-278-VD-6019-EL-DIA-0031-01
EQUIPMENT NO.	320-K-020
EQUIPMENT LOCATION	IRAN, ONSHORE
THIS DRAWING IS OWNED BY AIRPACK, AND SHALL NOT BE PRINTED OR COPIED IN ANY OTHER WAY THAN WITH AIRPACKS PERMISSION!	

SUBJECT		Cable-connection diagram =320-K-020+300JDAN-820-300CDAN820	
ADAPTED TO P&ID REVISION	07		
CLIENT	LAVAN INDUSTRY DEVELOPMENT COMPANY (LIDCO)		
CLIENT REF.	INTEGRATED METHANOL AND AMMONIA PLANT		
AIRPACK REF.	17735-30 Loop Diagrams		

DRAWN BY	RTR	= 320-K-020
CHECKED BY	RBE	+ 300JDAN820
LAST MODIFICATION DATE	2023-12-20	CURRENT PAGE
AIRPACK DWG NO.	17735-30	
REVISION	03	
TOTAL PAGE AMOUNT	9	

# Loop Diagrams

Internal targets



External targets




CLIENT DWG NO.	N-278-VD-6019-EL-DIA-0031-01
EQUIPMENT NO.	320-K-020
EQUIPMENT LOCATION	IRAN, ONSHORE
THIS DRAWING IS OWNED BY AIRPACK, AND SHALL NOT BE PRINTED OR COPIED IN ANY OTHER WAY THAN WITH AIRPACKS PERMISSION!	

SUBJECT		DRAWN BY		RTR	
Cable-connection diagram =320-K-020+300JDAN-820-300CDAN820		= 320-K-020		+ 300JDAN820	
ADAPTED TO P&ID REVISION	07	CHECKED BY		RBE	
CLIENT	LAVAN INDUSTRY DEVELOPMENT COMPANY (LIDCO)	LAST MODIFICATION DATE		2023-12-20	
CLIENT REF.	INTEGRATED METHANOL AND AMMONIA PLANT	AIRPACK DWG NO.		17735-30	
AIRPACK REF.	17735-30 Loop Diagrams	REVISION		03	
		TOTAL PAGE AMOUNT		10	

CURRENT PAGE	
--------------	--

# Loop Diagrams

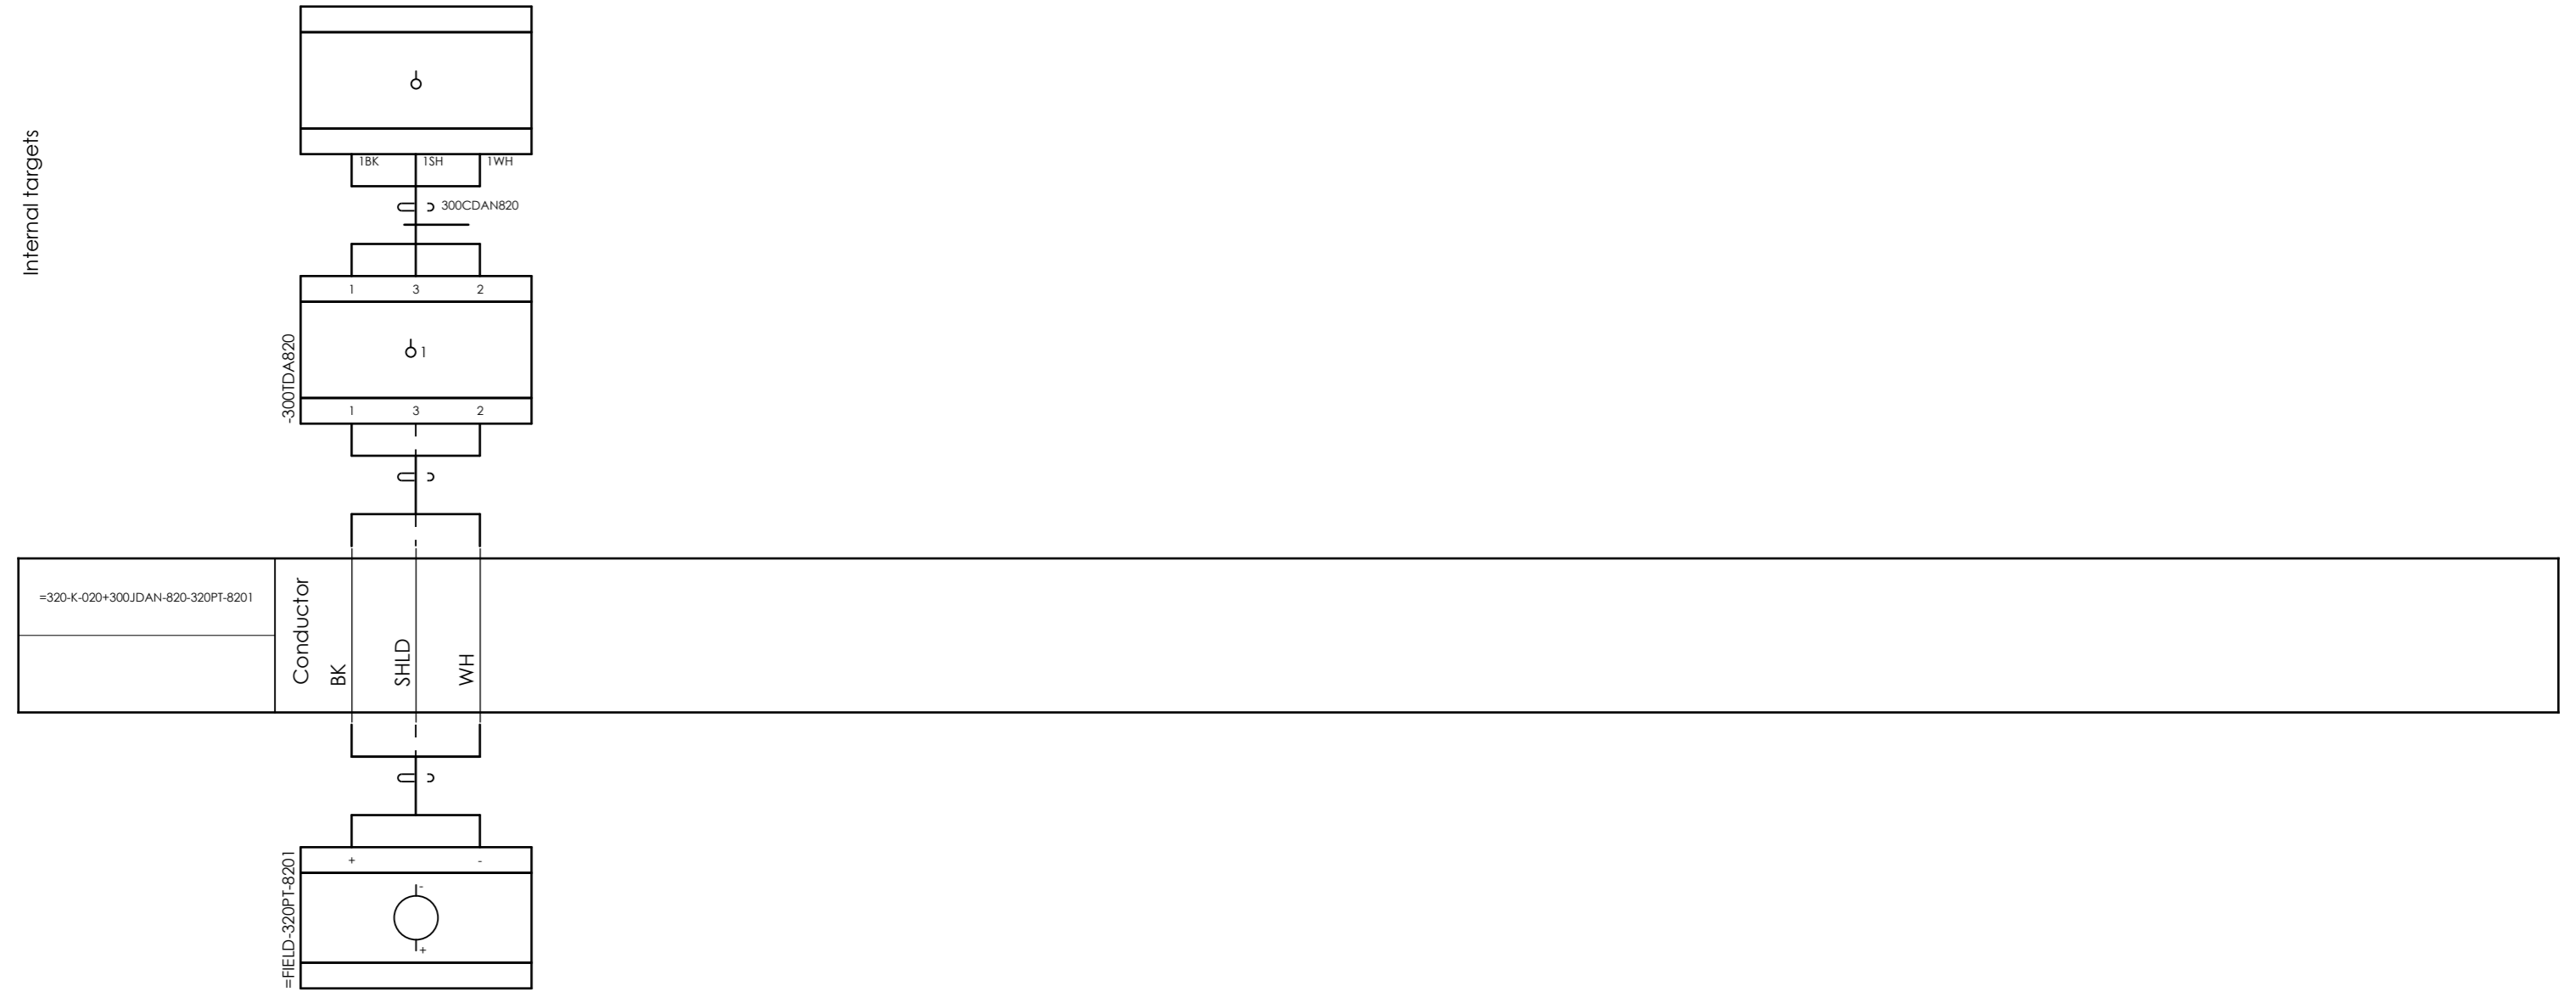


CLIENT DWG NO.	N-278-VD-6019-EL-DIA-0031-01
EQUIPMENT NO.	320-K-020
EQUIPMENT LOCATION	IRAN, ONSHORE
THIS DRAWING IS OWNED BY AIRPACK, AND SHALL NOT BE PRINTED OR COPIED IN ANY OTHER WAY THAN WITH AIRPACKS PERMISSION!	

SUBJECT Cable-connection diagram =320-K-020+300JDAN-820-320PT-8201	
ADAPTED TO P&ID REVISION	07
CLIENT	LAVAN INDUSTRY DEVELOPMENT COMPANY (LIDCO)
CLIENT REF.	INTEGRATED METHANOL AND AMMONIA PLANT
AIRPACK REF.	17735-30 Loop Diagrams

DRAWN BY	RTR	= 320-K-020
CHECKED BY	RBE	+ 300JDAN820
LAST MODIFICATION DATE	2023-12-20	CURRENT PAGE
AIRPACK DWG NO.	17735-30	
REVISION	03	
TOTAL PAGE AMOUNT	11	

# Loop Diagrams

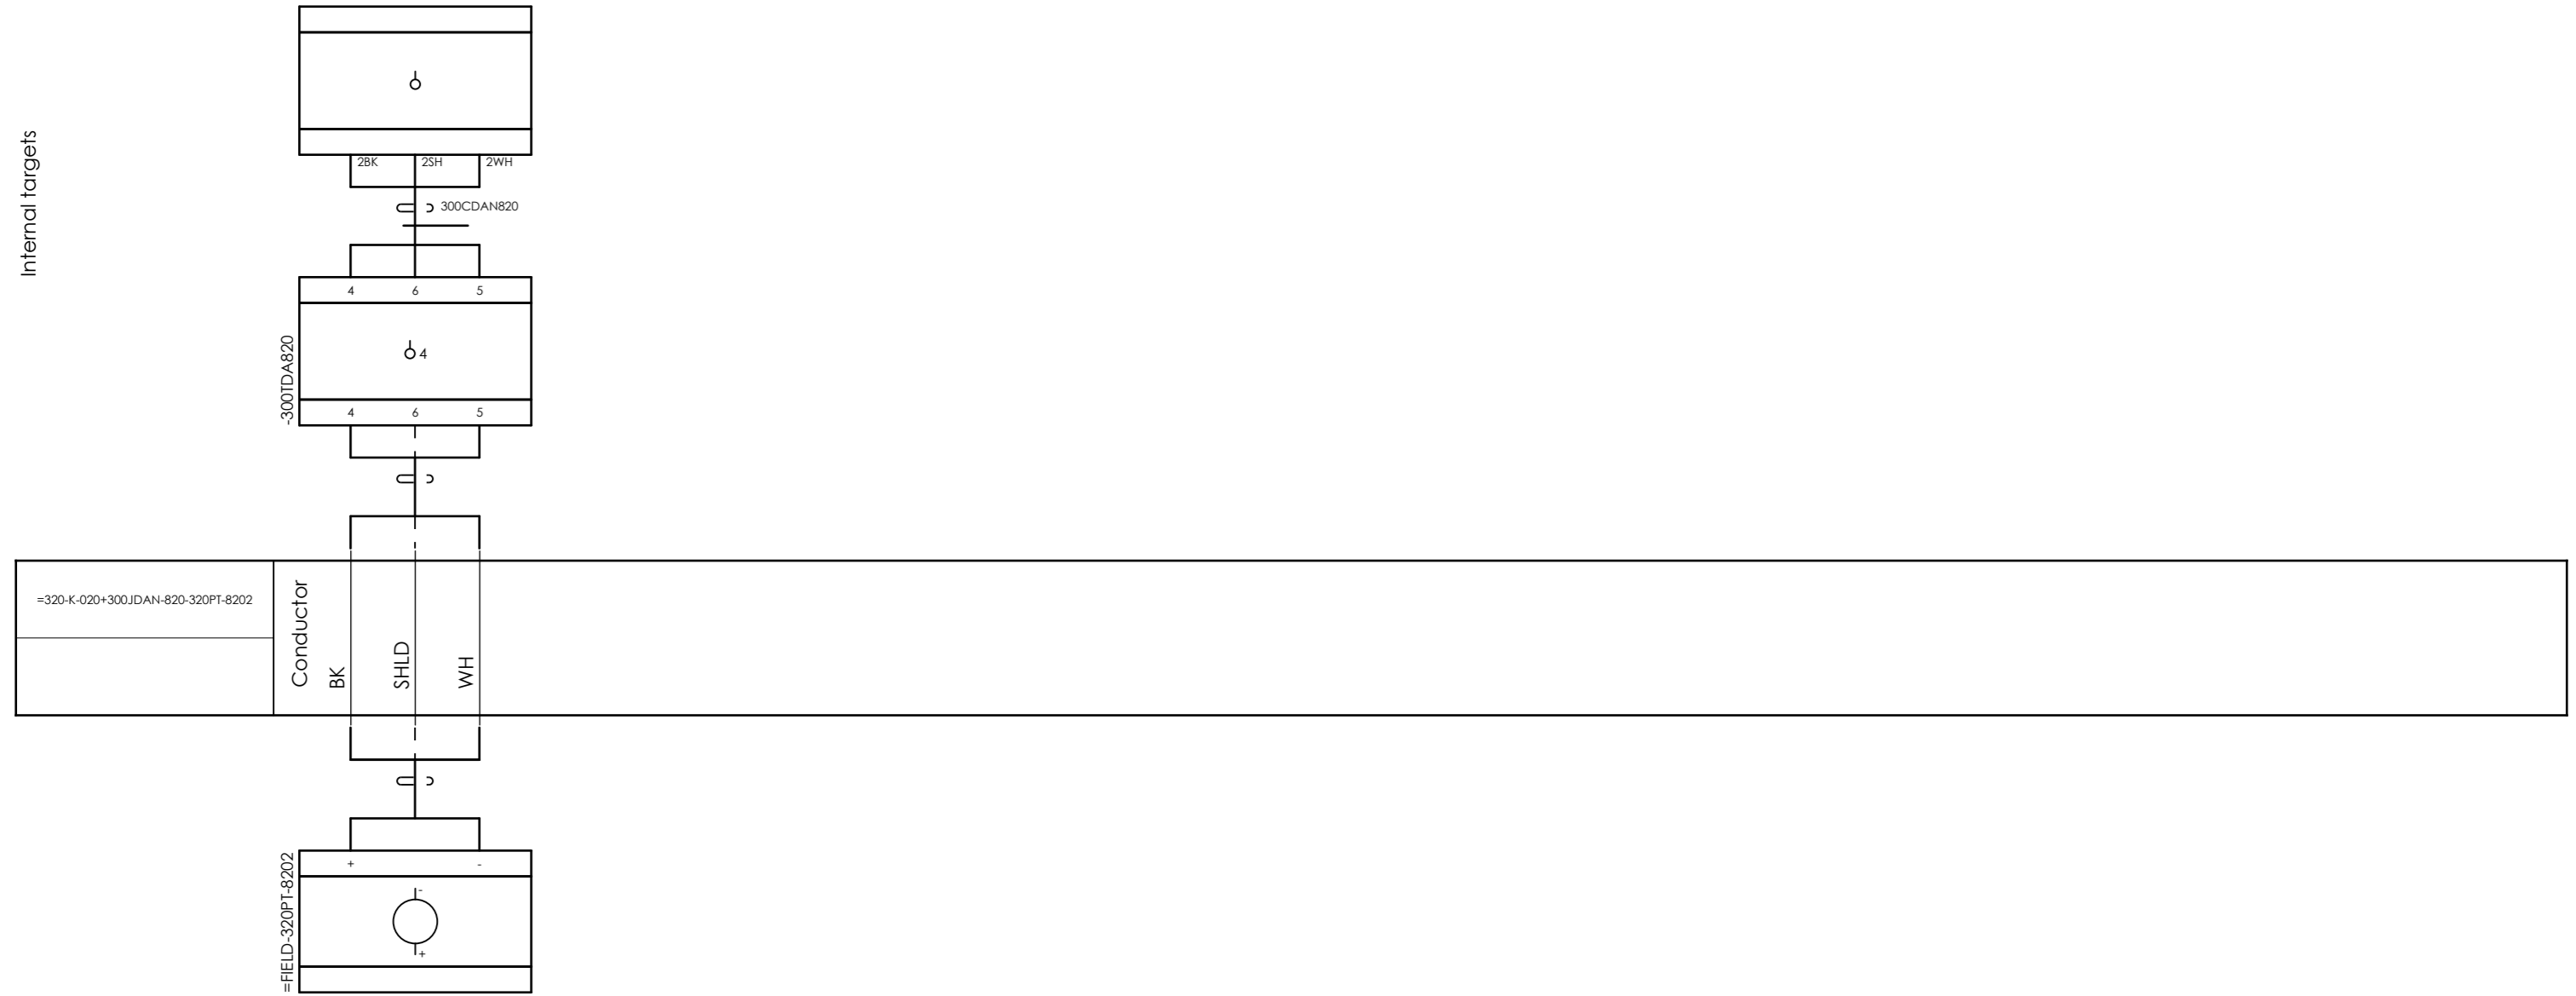


CLIENT DWG NO.	N-278-VD-6019-EL-DIA-0031-01
EQUIPMENT NO.	320-K-020
EQUIPMENT LOCATION	IRAN, ONSHORE
THIS DRAWING IS OWNED BY AIRPACK, AND SHALL NOT BE PRINTED OR COPIED IN ANY OTHER WAY THAN WITH AIRPACKS PERMISSION!	

SUBJECT		DRAWN BY		RTR	
Cable-connection diagram =320-K-020+300JDAN-820-320PT-8202		= 320-K-020		+ 300JDAN820	
ADAPTED TO P&ID REVISION	07	LAST MODIFICATION DATE	2023-12-20		
CLIENT	LAVAN INDUSTRY DEVELOPMENT COMPANY (LIDCO)	AIRPACK DWG NO.	17735-30		
CLIENT REF.	INTEGRATED METHANOL AND AMMONIA PLANT	REVISION	03		
AIRPACK REF.	17735-30 Loop Diagrams	TOTAL PAGE AMOUNT	12		

CURRENT PAGE	
--------------	--

# Loop Diagrams

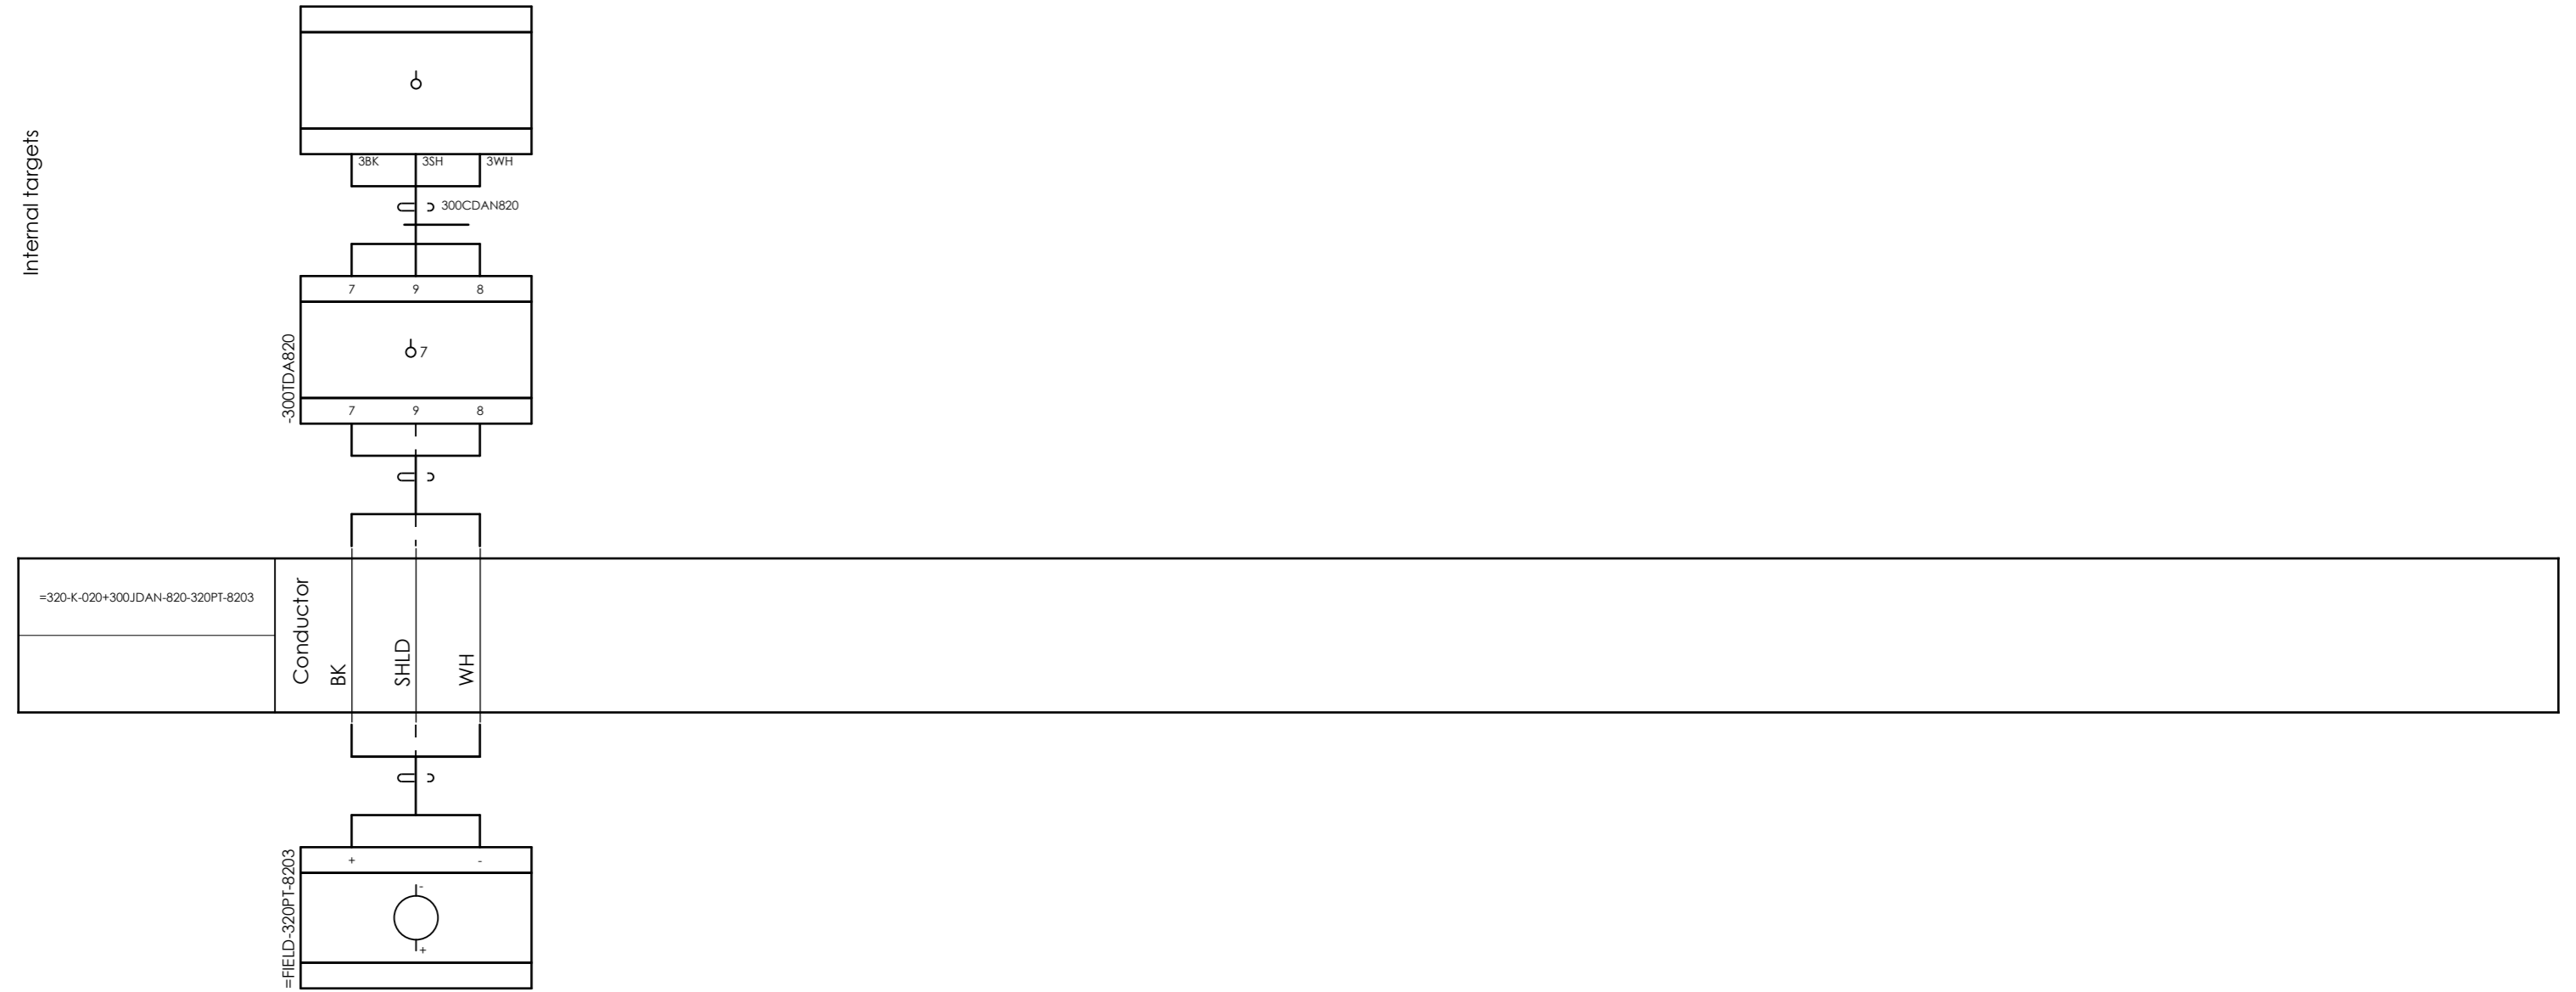


CLIENT DWG NO.	N-278-VD-6019-EL-DIA-0031-01
EQUIPMENT NO.	320-K-020
EQUIPMENT LOCATION	IRAN, ONSHORE
THIS DRAWING IS OWNED BY AIRPACK, AND SHALL NOT BE PRINTED OR COPIED IN ANY OTHER WAY THAN WITH AIRPACKS PERMISSION!	

SUBJECT Cable-connection diagram =320-K-020+300JDAN-820-320PT-8203	
ADAPTED TO P&ID REVISION	07
CLIENT	LAVAN INDUSTRY DEVELOPMENT COMPANY (LIDCO)
CLIENT REF.	INTEGRATED METHANOL AND AMMONIA PLANT
AIRPACK REF.	17735-30 Loop Diagrams

DRAWN BY	RTR	= 320-K-020
CHECKED BY	RBE	+ 300JDAN820
LAST MODIFICATION DATE	2023-12-20	CURRENT PAGE
AIRPACK DWG NO.	17735-30	
REVISION	03	
TOTAL PAGE AMOUNT	13	

# Loop Diagrams

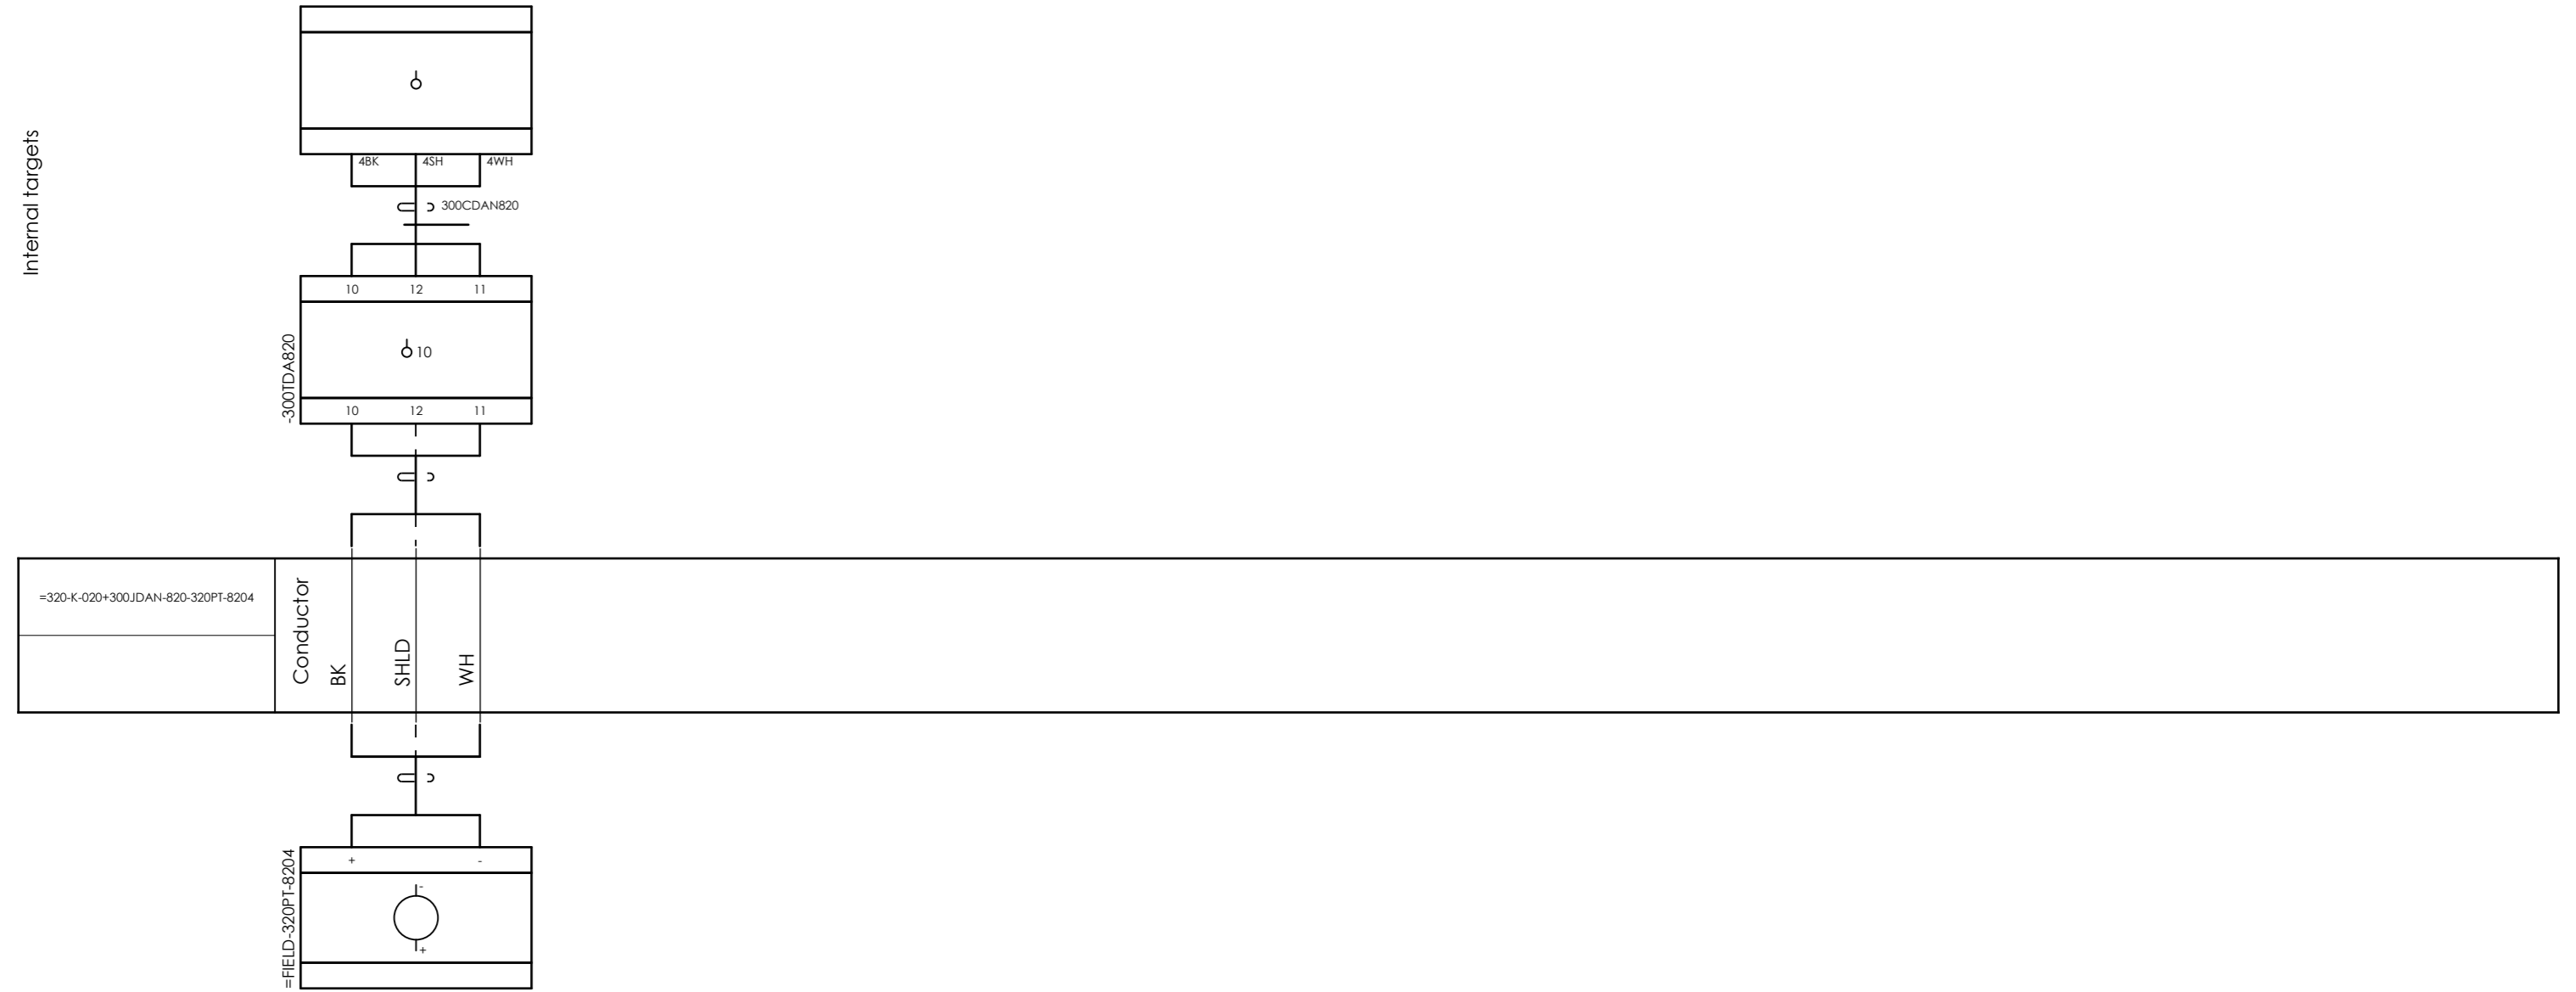

CLIENT DWG NO.	N-278-VD-6019-EL-DIA-0031-01
EQUIPMENT NO.	320-K-020
EQUIPMENT LOCATION	IRAN, ONSHORE
THIS DRAWING IS OWNED BY AIRPACK, AND SHALL NOT BE PRINTED OR COPIED IN ANY OTHER WAY THAN WITH AIRPACKS PERMISSION!	

SUBJECT		DRAWN BY		RTR		= 320-K-020	
Cable-connection diagram =320-K-020+300JDAN-820-320PT-8204		CHECKED BY		RBE		+ 300JDAN820	
ADAPTED TO P&ID REVISION	07	LAST MODIFICATION DATE		2023-12-20		CURRENT PAGE	
CLIENT	LAVAN INDUSTRY DEVELOPMENT COMPANY (LIDCO)	AIRPACK DWG NO.		17735-30			
CLIENT REF.	INTEGRATED METHANOL AND AMMONIA PLANT	REVISION		03			
AIRPACK REF.	17735-30 Loop Diagrams	TOTAL PAGE AMOUNT		14			

# Loop Diagrams



CLIENT DWG NO.	N-278-VD-6019-EL-DIA-0031-01
EQUIPMENT NO.	320-K-020
EQUIPMENT LOCATION	IRAN, ONSHORE
THIS DRAWING IS OWNED BY AIRPACK, AND SHALL NOT BE PRINTED OR COPIED IN ANY OTHER WAY THAN WITH AIRPACKS PERMISSION!	

SUBJECT Cable-connection diagram =320-K-020+300JDAN-820-320TT-8201	
ADAPTED TO P&ID REVISION	07
CLIENT	LAVAN INDUSTRY DEVELOPMENT COMPANY (LIDCO)
CLIENT REF.	INTEGRATED METHANOL AND AMMONIA PLANT
AIRPACK REF.	17735-30 Loop Diagrams

DRAWN BY	RTR	= 320-K-020
CHECKED BY	RBE	+ 300JDAN820
LAST MODIFICATION DATE	2023-12-20	CURRENT PAGE
AIRPACK DWG NO.	17735-30	
REVISION	03	
TOTAL PAGE AMOUNT	15	

# Loop Diagrams




CLIENT DWG NO.	N-278-VD-6019-EL-DIA-0031-01
EQUIPMENT NO.	320-K-020
EQUIPMENT LOCATION	IRAN, ONSHORE
THIS DRAWING IS OWNED BY AIRPACK, AND SHALL NOT BE PRINTED OR COPIED IN ANY OTHER WAY THAN WITH AIRPACKS PERMISSION!	

SUBJECT Cable-connection diagram =320-K-020+300JDAN-820-320TT-8202	
ADAPTED TO P&ID REVISION	07
CLIENT	LAVAN INDUSTRY DEVELOPMENT COMPANY (LIDCO)
CLIENT REF.	INTEGRATED METHANOL AND AMMONIA PLANT
AIRPACK REF.	17735-30 Loop Diagrams

DRAWN BY	RTR	= 320-K-020
CHECKED BY	RBE	+ 300JDAN820
LAST MODIFICATION DATE	2023-12-20	CURRENT PAGE
AIRPACK DWG NO.	17735-30	
REVISION	03	
TOTAL PAGE AMOUNT	16	

# Loop Diagrams

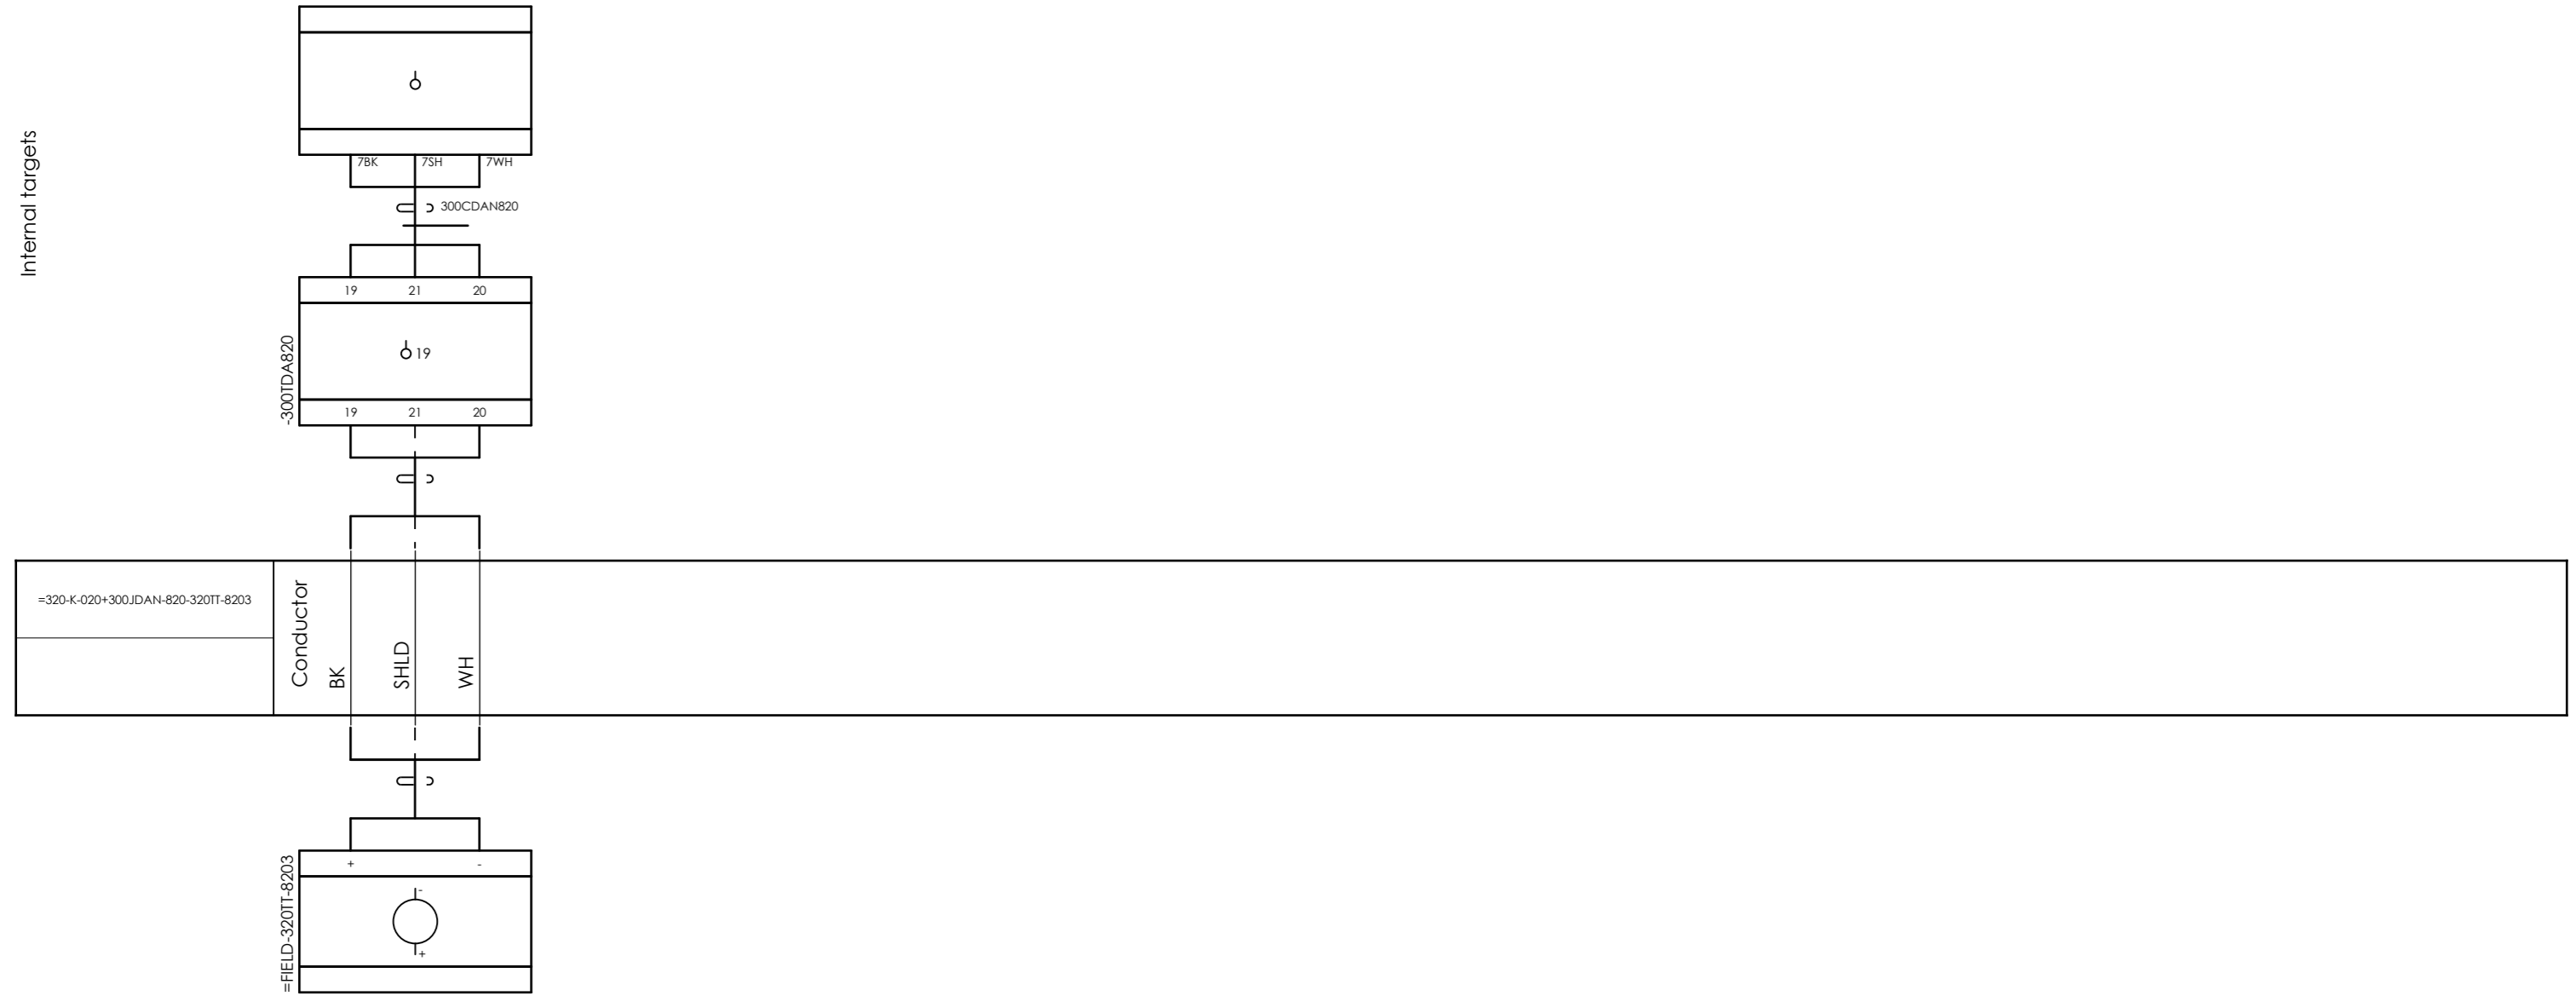

CLIENT DWG NO.	N-278-VD-6019-EL-DIA-0031-01
EQUIPMENT NO.	320-K-020
EQUIPMENT LOCATION	IRAN, ONSHORE
THIS DRAWING IS OWNED BY AIRPACK, AND SHALL NOT BE PRINTED OR COPIED IN ANY OTHER WAY THAN WITH AIRPACKS PERMISSION!	

SUBJECT		DRAWN BY		RTR	
Cable-connection diagram =320-K-020+300JDAN-820-320TT-8203		= 320-K-020		+ 300JDAN820	
ADAPTED TO P&ID REVISION	07	LAST MODIFICATION DATE	2023-12-20		
CLIENT	LAVAN INDUSTRY DEVELOPMENT COMPANY (LIDCO)	AIRPACK DWG NO.	17735-30		
CLIENT REF.	INTEGRATED METHANOL AND AMMONIA PLANT	REVISION	03		
AIRPACK REF.	17735-30 Loop Diagrams	TOTAL PAGE AMOUNT	17		

CURRENT PAGE	
--------------	--

# Loop Diagrams




CLIENT DWG NO.	N-278-VD-6019-EL-DIA-0031-01
EQUIPMENT NO.	320-K-020
EQUIPMENT LOCATION	IRAN, ONSHORE
THIS DRAWING IS OWNED BY AIRPACK, AND SHALL NOT BE PRINTED OR COPIED IN ANY OTHER WAY THAN WITH AIRPACKS PERMISSION!	

SUBJECT Cable-connection diagram =320-K-020+300JDAN-820-320TT-8204	
ADAPTED TO P&ID REVISION	07
CLIENT	LAVAN INDUSTRY DEVELOPMENT COMPANY (LIDCO)
CLIENT REF.	INTEGRATED METHANOL AND AMMONIA PLANT
AIRPACK REF.	17735-30 Loop Diagrams

DRAWN BY	RTR	= 320-K-020
CHECKED BY	RBE	+ 300JDAN820
LAST MODIFICATION DATE	2023-12-20	CURRENT PAGE
AIRPACK DWG NO.	17735-30	
REVISION	03	
TOTAL PAGE AMOUNT	18	

# Loop Diagrams

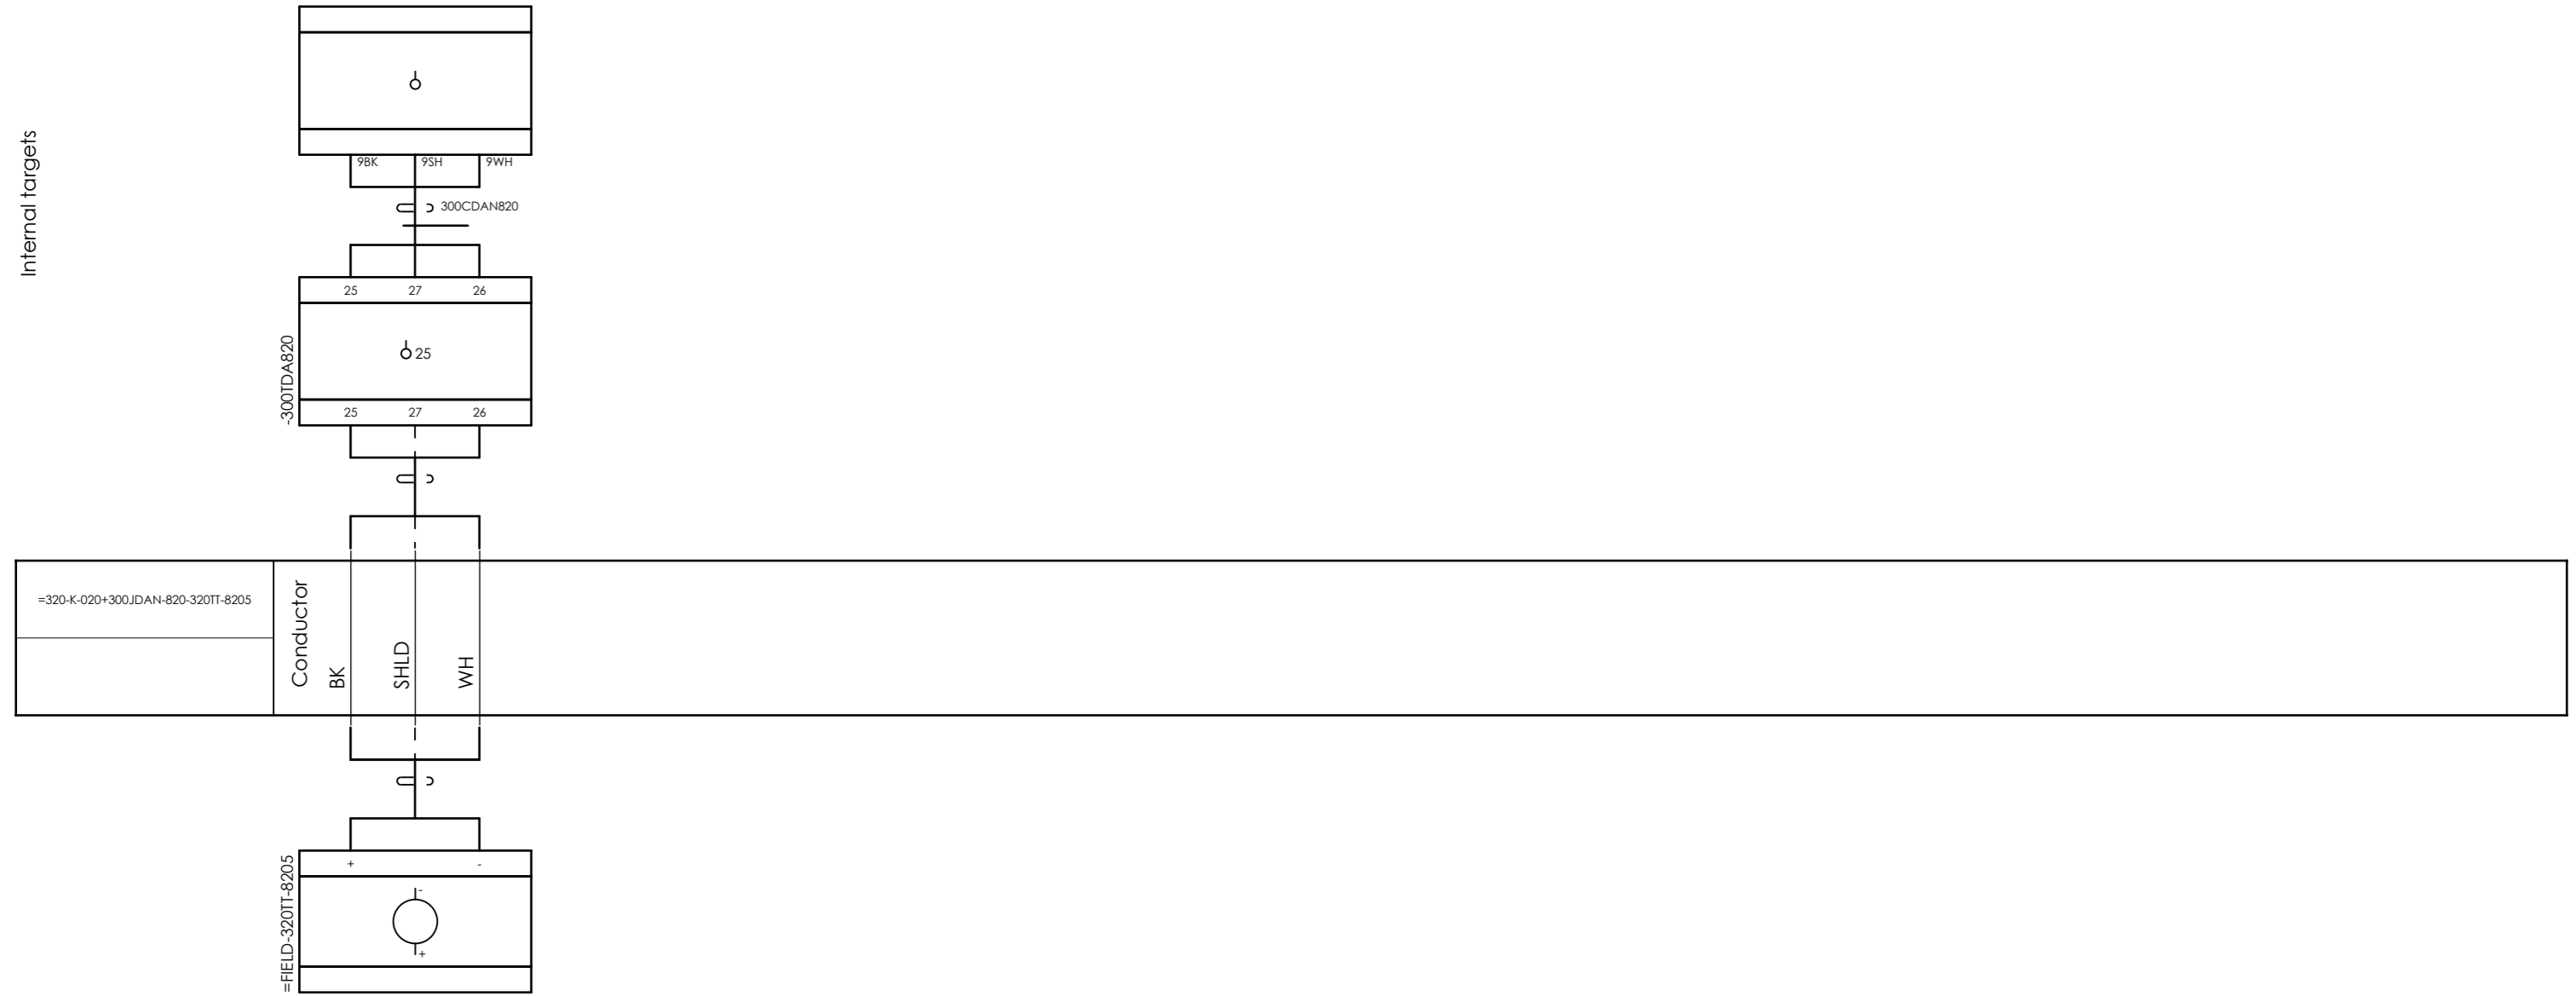

CLIENT DWG NO.	N-278-VD-6019-EL-DIA-0031-01
EQUIPMENT NO.	320-K-020
EQUIPMENT LOCATION	IRAN, ONSHORE
THIS DRAWING IS OWNED BY AIRPACK, AND SHALL NOT BE PRINTED OR COPIED IN ANY OTHER WAY THAN WITH AIRPACKS PERMISSION!	

SUBJECT		DRAWN BY		RTR		= 320-K-020	
Cable-connection diagram =320-K-020+300JDAN-820-320TT-8205		CHECKED BY		RBE		+ 300JDAN820	
ADAPTED TO P&ID REVISION	07	LAST MODIFICATION DATE		2023-12-20		CURRENT PAGE	
CLIENT	LAVAN INDUSTRY DEVELOPMENT COMPANY (LIDCO)	AIRPACK DWG NO.		17735-30			
CLIENT REF.	INTEGRATED METHANOL AND AMMONIA PLANT	REVISION		03			
AIRPACK REF.	17735-30 Loop Diagrams	TOTAL PAGE AMOUNT		19			

# Loop Diagrams



CLIENT DWG NO.	N-278-VD-6019-EL-DIA-0031-01
EQUIPMENT NO.	320-K-020
EQUIPMENT LOCATION	IRAN, ONSHORE
THIS DRAWING IS OWNED BY AIRPACK, AND SHALL NOT BE PRINTED OR COPIED IN ANY OTHER WAY THAN WITH AIRPACKS PERMISSION!	

SUBJECT		DRAWN BY		RTR	
Cable-connection diagram =320-K-020+300JDAN-820-320PCV-8201		= 320-K-020		+ 300JDAN820	
ADAPTED TO P&ID REVISION	07	LAST MODIFICATION DATE	2023-12-20		
CLIENT	LAVAN INDUSTRY DEVELOPMENT COMPANY (LIDCO)	AIRPACK DWG NO.	17735-30		
CLIENT REF.	INTEGRATED METHANOL AND AMMONIA PLANT	REVISION	03		
AIRPACK REF.	17735-30 Loop Diagrams	TOTAL PAGE AMOUNT	20		

CURRENT PAGE	
--------------	--